


Map No. KANSAS Seg. 32 Twp. 13 R. 15^w
 Well No. 33 - Speer Farm _____
Mid West Company _____

NORTH

WEST

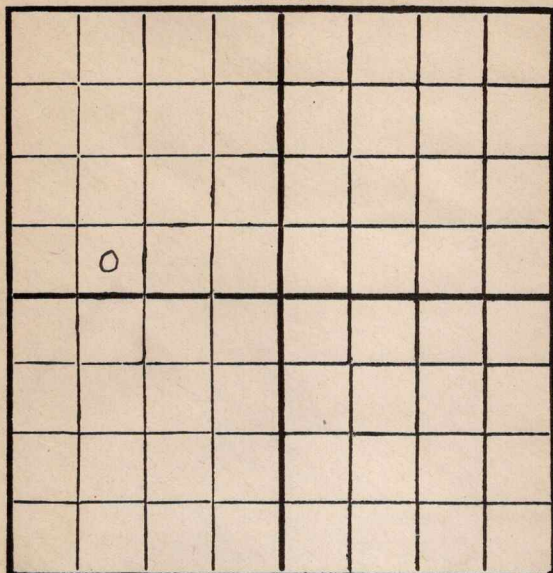

EAST

SOUTH

Location _____

Drilling Remarks _____

Rig Up _____

Drilling Remarks _____

RECORD

Cased _____ in. _____ ft.

Sand _____

Gas _____

Oil _____

Total Depth _____

PRODUCTION

1st 24 hrs. Nat. _____

1st 24 hrs. after shot _____

Gas _____ cu. ft. _____

Dry Hole _____

Abandoned _____


Map No. **KANSAS** Sec. *32* Twp. *13* R. *15^w*
Well No. *33- Spear* Farm
Mid west Company

_____ Ft. from N. Line

330 Ft. from S. Line

_____ Ft. from E. Line

990 Ft. from W. Line

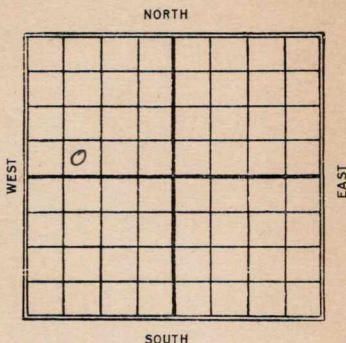

1929

Date

REPORT

<i>10/16</i>	<i>Location</i>
<i>10/23</i>	<i>Log</i>
<i>10/30</i>	<i>Log & tools</i>
<i>11/6</i>	<i>Log 435</i>
<i>11/13</i>	<i>Log 435</i>
<i>11/20</i>	<i>" 715</i>
<i>11/27</i>	<i>" 1045</i>
<i>12/4</i>	<i>" 3015</i>
<i>12/11</i>	<i>" 2610</i>
<i>12/18</i>	<i>" 2725</i>
<i>12/23</i>	<i>" 3040</i>
<i>12/30</i>	<i>" 3145</i>
<i>1930</i>	<i>Drly by tools 3145</i>
<i>1/8</i>	<i>Drly by tools 3145</i>
<i>1/15</i>	<i>—</i>
<i>1/22</i>	<i>—</i>
<i>1/29</i>	<i>—</i>
<i>2/5</i>	<i>—</i>
<i>2/12</i>	<i>—</i>
<i>2/19</i>	<i>Pay 3316-17½ Filled up 2000' oil in 2 hrs.</i>
<i>2/26</i>	<i>Isq. swab -</i>

3/5- Sand ⁷³⁸²⁸⁷ 3316-17 1/2
T.D. 3317 1/2'

Swab 115 bbl oil
and 50 " water
Pump.

Map No. **KANSAS** Sec. 32 Twp. 13 R. 10W

Well No. 33 Speer

Mid West Company

Contractor

SECTION PLAT

Ft. from N. Line

330 Ft. from S. Line

Ft. from E. Line

990 Ft. from W. Line

FIRST REPORTS

0			

Location ✓

Rig up

Drilling and Remarks:

RECORD

Cased in., ft.

Sand

Gas

Oil

Total Depth

PRODUCTION

1st 24 hrs. Nat.

1st 24 hrs. after shot

Gas Cu. Ft.

Dry Hole

Abandoned

Date

OCT 16 1920 S. J. LEWIS Scout

Russell
 Map No. **KANSAS** Sec. *22* Twp. *13* R. *15W*

72
 Well No. *33 Greer*

Mid West Company

Contractor

SECTION PLAT

..... Ft. from N. Line

230 Ft. from S. Line

..... Ft. from E. Line

990 Ft. from W. Line

<i>0</i>			

COMPLETED

Location

Rig up

Drilling and Remarks:

Swayx.

1154 1/2 oil

50 " water

RECORD

Cased..... in., ft.

Sand *3316 - 17 1/2*

Gas.....

Oil.....

Total Depth *17 1/2*

PRODUCTION

1st 24 hrs. Nat.....

1st 24 hrs. after shot.....

Gas..... Cu. Ft.

Dry Hole.....

Abandoned.....

Date

MAR 5 1930

..... 192.....

S. J. LEWIS Scout