


Section 7 Township 27 Range 11E

Well No. #5 Grundy "A"

Company Central Oil

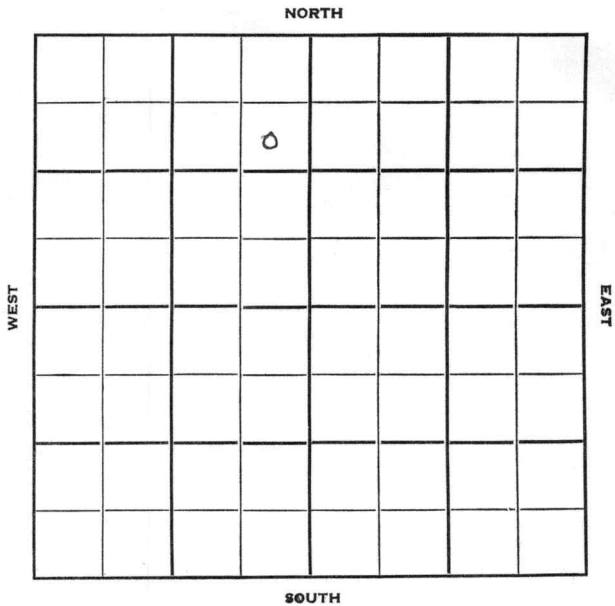

Greenwood

KANSAS

Sec. 7 Twp. 27 R. 11E

Well No. #5 Grundy "A" Farm

Central Oil Company

White & Ellis Contr. Contractor


990' Ft. from N. Line

\_\_\_\_\_ Ft. from S. Line

330' Ft. from E. Line

\_\_\_\_\_ Ft. from W. Line

SE NE NW

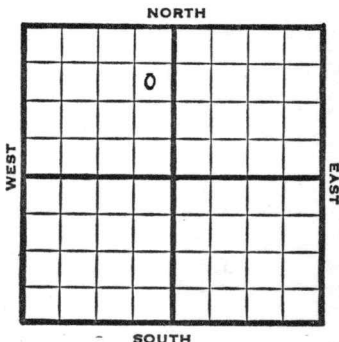

1950

?

REPORT

11/1

Spud 10-20-50  
Miss 1901-07 TD  
5" @ 1907'

11/8

Miss 1901-07  
5" @ 1907  
TD 1916  
FU 415' oil  
Comp 20 bopd  
Completed

COMPLETED

County Greenwood State Kansas

Sec. 7 (Blk. 27) (Sur. Rge.) 11E Map No.

Operator Central Oil

Well No. 5 Farm Grundy "A"

Elev. \_\_\_\_\_ Location SE NE NW

		0			

990 Ft. From N Line NW

330 Ft. From E Line Quarter

Ist. Report NOV 1 1950

Completion \_\_\_\_\_

Remarks \_\_\_\_\_

White & Ellis - Contr.

Spudding Date 10-20-50

Drlg. Data \_\_\_\_\_

Miss 1901-07 TD 5" @ 1907

J. E. TYRA

County Greenwood State Kansas

Sec. 7 (Blk. 27 (Sur. 11E Map No. 11E)  
(Twp.) (Rge.)

Operator Central Oil

Well No. 5 Farm Grundy "A"

Elev. \_\_\_\_\_ Location SE NE NW

		0			

**COMPLETE**

990Ft. From N Line NW

330Ft. From E Line Quarter

1st. Report

Completion NOV 8 1950

Remarks

White & Ellis

Spudding Date 10-20-50

Drlg. Data Oil well TD 1916

Miss. 1901-07 5" @ 1907 TD 1916

FU 415' oil Comp. 20 bopd