


McPherson

Section 21 Township 19 Range 1-W

Well No. 3 Shaw

Company T. C. Johnson et al

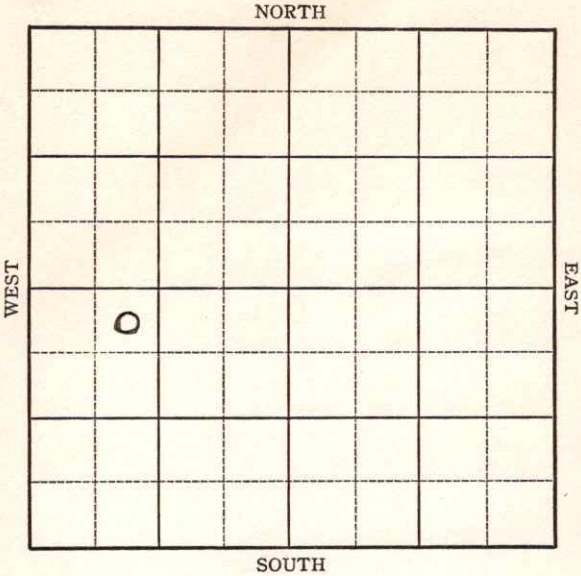

McPherson

KANSAS

Map No. _____ Sec. 21 Twp. 19 R1WWell No. 3 ShawT. C. Johnson etal Company

Contractor

FIRST REPORT

NE NW SW

330 Ft. from N. Line

_____ Ft. from S. Line

_____ Ft. from E. Line

990 Ft. from W. Line

SECTION PLAT

0			

Location _____

Rig up _____

Drilling and Remarks:
Cellar

RECORD

Cased _____ in., _____ ft.

Sand _____

Gas _____

Oil _____

Total Depth _____

PRODUCTION

1st 24 hrs. Nat. _____

1st 24 hrs. after shot _____

Gas _____ Cu. Ft.

Dry Hole _____

Abandoned _____

Date

NOV 3 1887

19

H. D. Hatfield Scout

McPherson **KANSAS**Map No. 43 Sec. 21 Twp. 19 R. 1WWell No. 3 Shaw
T. C. Johnson et al Company

Contractor

COMPLETED**SECTION PLAT**

NE NW SW

330 Ft. from N. Line

_____ Ft. from S. Line

_____ Ft. from E. Line

990 Ft. from W. Line

0			

Location _____

Rig up _____

Drilling and Remarks:

POT-298**RECORD**Cased 7 in., 3402 ft.Sand Wilcox 3400

Gas _____

Oil _____

Total Depth 3426**PRODUCTION**

1st 24 hrs. Nat. _____

1st 24 hrs. after shot _____

Gas _____ Cu. Ft.

Dry Hole _____

Abandoned _____

Date

DEC 15 193719H. D. HatfieldScout