


Section 33 Township 13 Range 15-W

Well Number #9 A.A. Mermis

Company Bridgeport

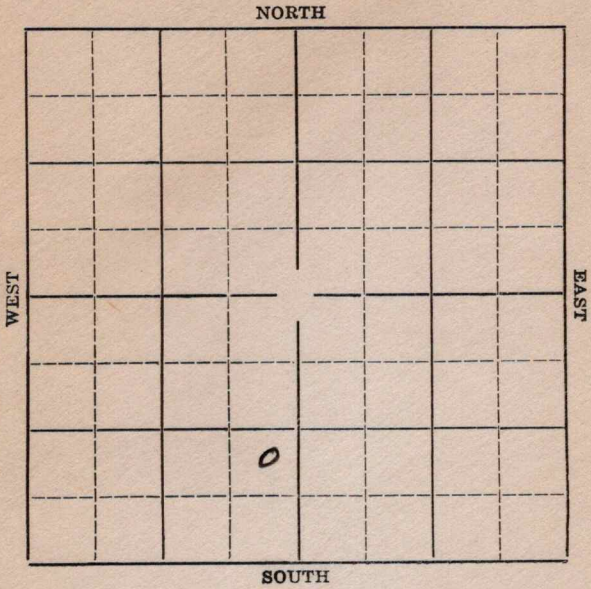

Sec. 33 Twp. 13 R. 15W

Well No. #9 A.A. Mermis Farm

Bridgeport Company


_____ Ft. from N. Line

990' Ft. from S. Line

330' Ft. from E. Line

_____ Ft. from W. Line

Elev. 1895

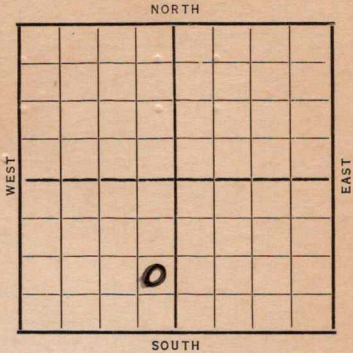

Date	REPORT
10/28	Location.
11/6	Building rig
11/12	Rig.
11/19	Rigging up
11/27	15" @ 421'. Drlg. 520'.
12/3---	
12/10	Drlg. 2100'.
12/17	2100' Rig burned. Bldg. rig
12/24	Rigging up.
12/29	" "
1937	
1/7	2575' underream 8".
1/14	Drlg. 2760'. Show oil.
1/21	8" @ 2598'. K.C.L. 3055' . 6" @ 3075'. 1 bailer oil 3080-85'. Drlg. 3100'.
1/28	No report.
2/4	Granite 8398 TD 3324 Plug back 3298
2/11	96 shots 3282-90 No Test.
2/19	" " " " "

OVER

73829K

1937

2/24 Granite wash 3284'.

T. D. 3324'.

P. B. 3298'.

Pump 241 oil.

COMPLETED

Map No. 72 Sec. 33 Twp. 18 R. 15W

Well No. 9 aa Nernis

Bridgeport Company

Contractor

SECTION PLAT

		0	

_____ Ft. from N. Line

990 Ft. from S. Line

380 Ft. from E. Line

_____ Ft. from W. Line

FIRST REPORT

Location ✓

Rig up _____

Drilling and Remarks:

RECORD

Cased _____ in., _____ ft.

Sand _____

Gas _____

Oil _____

Total Depth _____

PRODUCTION

1st 24 hrs. Nat. _____

1st 24 hrs. after shot _____

Gas _____ Cu. Ft.

Dry Hole _____

Abandoned _____

Date

OCT 28 1936

S. J. LEWIS

Scout

Map No. 72 Sec. 33 Twp. 13 R. 15W

Well No. 9 a a Mermis

Bridgeport Company

Contractor

SECTION PLAT

_____ Ft. from N. Line

990 Ft. from S. Line

330 Ft. from E. Line

_____ Ft. from W. Line

COMPLETED

RECORD

Location _____

Cased _____ in., _____ ft.

Rig up _____

Sand _____

Drilling and Remarks:

Gas _____

Granite Wash.

Oil _____

3284

Total Depth 3324

P.B. 3298

PRODUCTION

Pump. 24/ oil

1st 24 hrs. Nat. _____

1st 24 hrs. after shot _____

Gas _____ Cu. Ft.

Dry Hole _____

Abandoned _____

Date

FEB 24 1937

19

S. J. LEWIS

Scout