


Map No. **KANSAS** Sec. 33 Twp. 13 R. 15W
 Well No. 1—Gorham Farm
Tom Johnson & Vickers Company

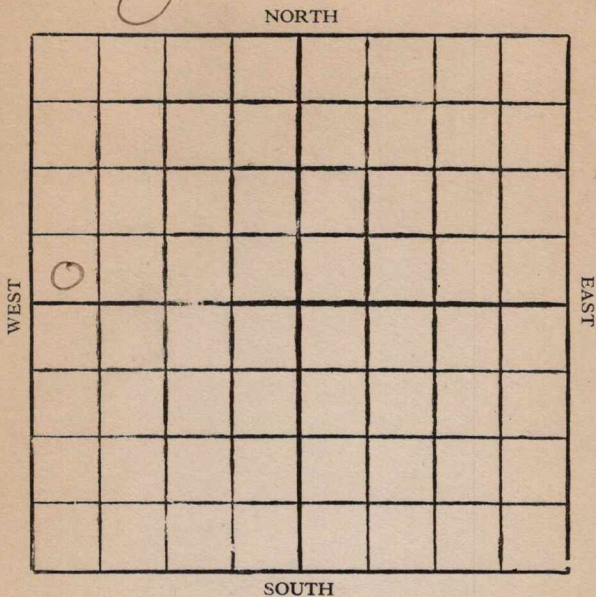

Location

Drilling Remarks

.....

.....

RECORD

Cased in. ft.

Sand

Gas

Oil

Total Depth

Rig Up

Drilling Remarks

.....

.....

PRODUCTION

1st 24 hrs. Nat.

1st 24 hrs. after shot

Gas cu. ft.

Dry Hole

Abandoned

Map No. **KANSAS** Sec. 33 Twp. 13 R. 15 W.
 Well No. 1-Gorkham Farm
Lorn Johnson & Vickers Company

NORTH

Ft. from N. Line

330 Ft. from S. Line

Ft. from E. Line

330 Ft. from W. Line

WEST

EAST

SOUTH

1928

Date

REPORT

2/22	Rig
2/29	
3/7	Spud
3/14	Spud 200
3/21	Drlg 695
3/28	" 995
4/4	" 1400
4/11	" 2390
4/18	T.D. 2760 - Cem Care -
4/25	Top Sand 3059 - Show oil 3094 - 3098 show water - water exhausted - drlg 3132 -
5/2	Top Sand 3324 - 26 - filled up 2000' oil in 45 min -
5/9	Swab 52 1/2 bbls 8 hrs.
5/16	Testing - 350 bbls oil 10% water - 4% B.S. 10 hrs.
5/23	Top sand 3324 T.D. 3326 in sand swab 300 bbls 24 hrs Cutting 10 %

map
Form 26-1M Bks. 3-23-11959.

Map No. KANSAS Sec. 33 Twp. 13 R. 15W

Well No. 1 Gorham

Ton Johnson & Vickers Company

Contractor

SECTION PLAT

----- Ft. from N. Line

330 Ft. from S. Line

----- Ft. from E. Line

330 Ft. from W. Line

FIRST REPORTS

Location -----

Rig up -----

Drilling and Remarks:

Rig

RECORD

Cased ----- in., ----- ft.

Sand -----

Gas -----

Oil -----

Total Depth -----

PRODUCTION

1st 24 hrs. Nat. -----

1st 24 hrs. after shot -----

Gas ----- Cu. Ft.

Dry Hole -----

Abandoned -----

Date

FEB 22 1928

192

S. J. LEWIS Scout

Map No. KANSAS Sec. 33 Twp. 13 R. 15WWell No. 1 GorhamTom Johnson & Vickers Company

Contractor

SECTION PLAT

----- Ft. from N. Line

330 Ft. from S. Line

----- Ft. from E. Line

330 Ft. from W. Line

COMPLETED

Location -----

Rig up -----

Drilling and Remarks:

Top Sand 3324Total Depth in sand3326Swabbing 300 ft24 hrs. @ 10%10%

RECORD

Cased ----- in., ----- ft.

Sand -----

Gas -----

Oil -----

Total Depth -----

PRODUCTION

1st 24 hrs. Nat. -----

1st 24 hrs. after shot -----

Gas ----- Cu. Ft.

Dry Hole -----

Abandoned -----

Date

MAY 23 1920

192

S. J. LEWIS

Scout