


Map No. **KANSAS** Sec. 33 Twp. 13 R. 15w
 Well No. 1 - J. A. Mermis Farm
Sterns & Streeter Company

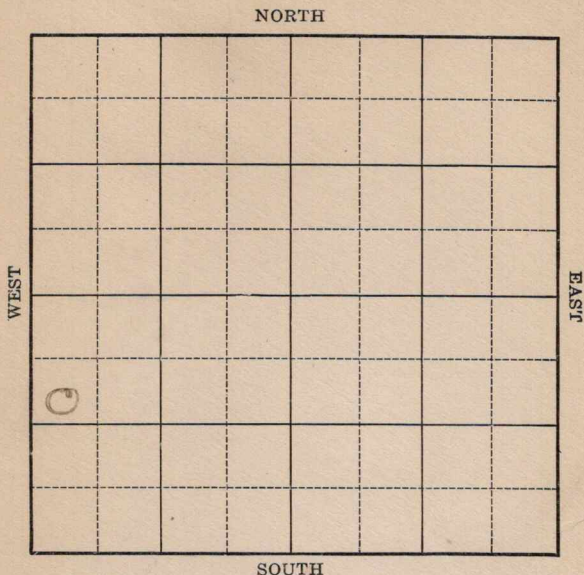

Location _____

Drilling Remarks _____

Rig Up _____

Drilling Remarks _____

RECORD

Cased _____ in. _____ ft.

Sand _____

Gas _____

Oil _____

Total Depth _____

PRODUCTION

1st 24 hrs. Nat. _____

1st 24 hrs. after shot _____

Gas _____ cu. ft.

Dry Hole _____

Abandoned _____

KANSASMap No. _____ Sec. 33 Twp. 13 R. 15WWell No. 1-J. A. Mermis FarmSterns & Streeter Company

NORTH

990 Ft. from N. Line

_____ Ft. from S. Line

_____ Ft. from E. Line

330 Ft. from W. Line1927

WEST

EAST

SOUTH

Date

REPORT

11/2	Rig Bldg.
11/9	Rig
11/16	Spud
11/22	Drlg 580
11/29	" 825
12/7	" 1225
12/14	" 1940
12/21	" 2475
12/28	" 2525
1928	
1/4	Drlg 2545
1/11	" 2785
1/18	T.D. 2799 - drlg out Cem -
1/25	Top Oswald 3060 - drlg 3063 showail -
1/31	T.D. 3317 - Awat + flow. 400 bbls 8 hrs -
2/15	pumping 831 bbls -
2/22	Top Oswald 3060 1/2 T.D. 3317 pumping 800 bbls 24 hrs

Map No. KANSAS Sec. 33 Twp. 13 R. 15W

Well No. J. A. Mermis

Stearns & Streeter Company

Contractor

SECTION PLAT

990 Ft. from N. Line

_____ Ft. from S. Line

_____ Ft. from E. Line

330 Ft. from W. Line

0			

COMPLETED

Location _____

Rig up _____

Drilling and Remarks:

Top Oswald 3060 1/2

TD 3317

Pumping 500884
24 hrs

RECORD

Cased _____ in., _____ ft.

Sand _____

Gas _____

Oil _____

Total Depth _____

PRODUCTION

1st 24 hrs. Nat. _____

1st 24 hrs. after shot _____

Gas _____ Cu. Ft.

Dry Hole _____

Abandoned _____

Date

FEB 22 1928

192

S. J. LEWIS

Scout

Map No. KANSAS Sec. 03 Twp. 13 R. 15W

Well No. J. A. Hermis

Sterns & Streeter Company

Contractor

SECTION PLAT

990 Ft. from N. Line

_____ Ft. from S. Line

_____ Ft. from E. Line

330 Ft. from W. Line

<u>0</u>			

FIRST REPORTS

Location _____

Rig up _____

Drilling and Remarks:

Rig Bldg

RECORD

Cased _____ in., _____ ft.

Sand _____

Gas _____

Oil _____

Total Depth _____

PRODUCTION

1st 24 hrs. Nat. _____

1st 24 hrs. after shot _____

Gas _____ Cu. Ft.

Dry Hole _____

Abandoned _____

Date

NOV 2 1927 S. J. LEWIS

192

Scout