

KANSAS

Rice

Section 22 Township 18 Range 10W

Well No. 1 Schultz


Company Anderson-Prichard

Wildcat

NORTH

WEST

EAST

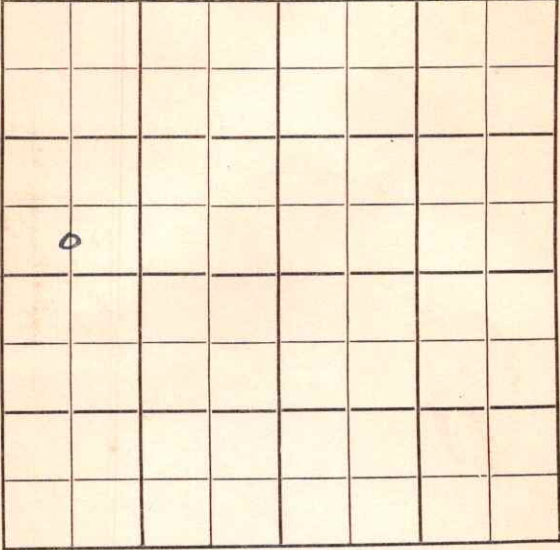

SOUTH

Rice

KANSAS

10W

Sec. 22 Twp. 18 R. 10W

Well No. #1 Schultz Farm

Anderson-Prichard Company

Wildcat

_____ Ft. from N. Line

330'


_____ Ft. from S. Line

_____ Ft. from E. Line

660'

_____ Ft. from W. Line

C S L SW NW

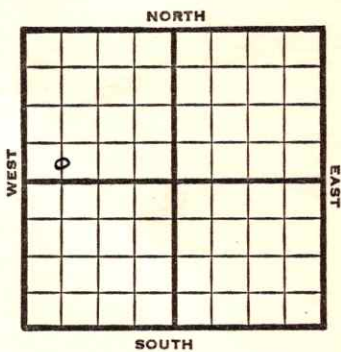

1949

Elev 1747'

REPORT

9/21

Location

9/28

10" @ 109'

Lansing 2881'

DST 2964-70 opn 1 hr

Rec 180' oil & 60' oil cut mud

850# bottom hole pressure

Drlg 2940'

10/5

Drlg 2926'

10/12

TD 3310'

Lans. 2913'

Arb. 3273'

Aband.

ABANDONED

Kansas

Map No. _____ Sec. 22 Twp. 18 R. 10WWell No. 1 Schultz

Anderson-Prichard _____ Company

Contractor

C S L SW NW

SECTION PLATT

_____ Ft. from N. Line

330 Ft. from S. Line

_____ Ft. from E. Line

660 Ft. from W. Line

Rice County

RECORD

Location X

Cased _____ in., _____ ft.

Rig up _____

Sand _____

Drilling and Remarks:

Gas _____

Oil _____

Total Depth _____

PRODUCTION

1st 24 hrs. Nat. _____

1st 24 hrs. after shot _____

Gas _____ Cu. Ft.

Dry Hole _____

Abandoned _____

Date

SEP 21 1949 19

S. J. LEWIS

Scout

Map No. _____ Sec. 22 Twp. 18 R. 10W

Well No. 1 Schultz

Anderson-Prichard Company

ABANDONED

Contractor

C S L SW NW

E 41747
SECTION PLAT

_____ Ft. from N. Line

330 Ft. from S. Line

_____ Ft. from E. Line

660 Ft. from W. Line

Rice County

RECORD

Location _____

Cased _____ in., _____ ft.

Rig up _____

Sand _____

Drilling and Remarks:

Gas _____

Oil _____

Total Depth 3310

Ham 2913

On 4/3/28

PRODUCTION

1st 24 hrs. Nat. _____

1st 24 hrs. after shot _____

Gas _____ Cu. Ft.

Dry Hole _____

Abandoned _____

Date

OCT 12 1949

19

S. J. LEWIS

Scout