


Map No. **KANSAS** Sec. 33 Twp. 13 R. 15^w
Well No. 4-Mermis Farm
Stearns & Struter Company

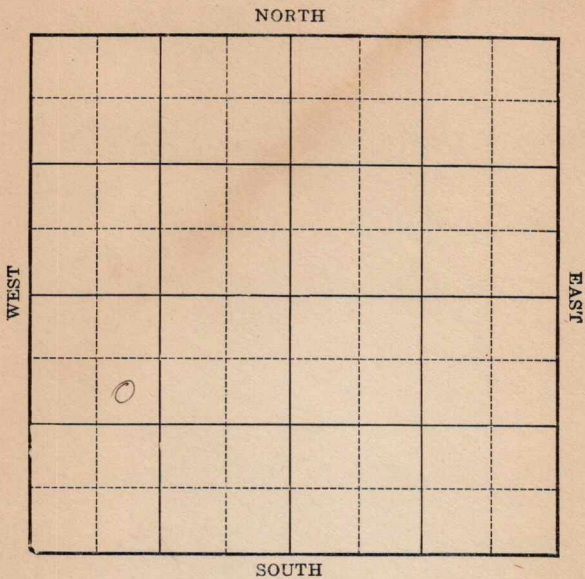

Location _____
Drilling Remarks _____

Rig Up _____
Drilling Remarks _____

RECORD

Cased _____ in. _____ ft.
Sand _____
Gas _____
Oil _____
Total Depth _____

PRODUCTION

1st 24 hrs. Nat. _____
1st 24 hrs. after shot _____
Gas _____ cu. ft.
Dry Hole _____
Abandoned _____

Map No. **KANSAS** Sec. 33 Twp. 13 R. 15^{SW}

Well No. 4-Murmis Farm
Stearns & Struter Company


990 Ft. from N. Line

_____ Ft. from S. Line

_____ Ft. from E. Line

990 Ft. from W. Line

1930

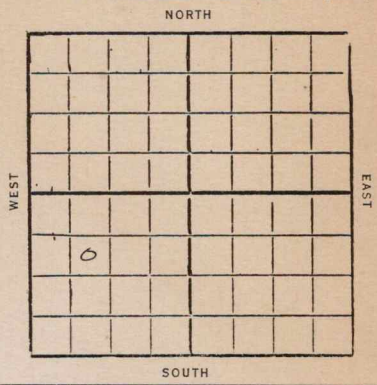

Date	REPORT
<u>12/10</u>	<u>Loc</u>
<u>12/17</u>	<u>Dry</u>
<u>12/23</u>	<u>325</u>
<u>12/30</u>	<u>" 630</u>
<u>1/31</u>	
<u>1/4</u>	
<u>1/7</u>	<u>" 825</u>
<u>1/14</u>	<u>" 1435</u>
<u>1/21</u>	<u>" 2000</u>
<u>1/28</u>	<u>" 2385</u>
<u>2/4</u>	<u>" 2790</u>
<u>2/11</u>	<u>" 2910</u>
<u>2/18</u>	<u>" 3195</u>
<u>2/25</u>	<u>Sand 3296-3300</u>
	<u>T.D. 3300</u>
	<u>Pump 28 bbl oil</u>
	<u>Comp.</u>

Russell

Map No. **KANSAS** Sec. 33 Twp. 13 R. 15WWell No. 72 4 MermisStearns & Streeter Company

Contractor

SECTION PLAT

990 Ft. from N. Line

Ft. from S. Line

Ft. from E. Line

990 Ft. from W. Line

FIRST REPORTS

Location ✓

Rig up

Drilling and Remarks:

RECORD

Cased _____ in., _____ ft.

Sand _____

Gas _____

Oil _____

Total Depth _____

PRODUCTION

1st 24 hrs. Nat. _____

1st 24 hrs. after shot _____

Gas _____ Cu. Ft.

Dry Hole _____

Abandoned _____

Date

DEC 10 1930 192S. J. LEWIS Scout

Russell 77
 Map No. **KANSAS** Sec. 33 Twp. 13 R. 15W

Well No. 4 Morris

Steam & Street Company

Contractor

SECTION PLAT

990 Ft. from N. Line

..... Ft. from S. Line

..... Ft. from E. Line

990 Ft. from W. Line

COMPLETED

Location.....

Rig up.....

Drilling and Remarks:

Pump 2808 ft.

RECORD

Cased..... in., ft.

Sand 3296-3300

Gas.....

Oil.....

Total Depth 3300

PRODUCTION

1st 24 hrs. Nat.....

1st 24 hrs. after shot.....

Gas..... Cu. Ft.

Dry Hole.....

Abandoned.....

Date

FEB 25 1931

S. J. LEWIS Scout