


Section 22 Township 18 Range 10 WWell No. ²~~#X~~ HerzogCompany Petroleum Inc.

NORTH

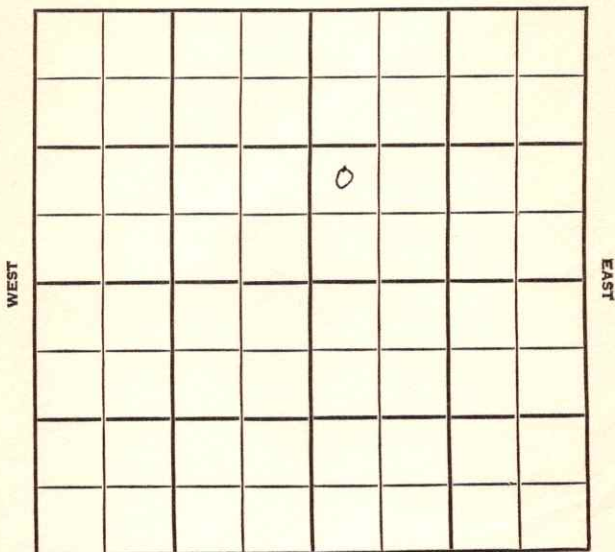

SOUTH

Rice

KANSAS

SEC.	TWP.	R.
22	18	10W

WELL NO.

#2
#1 Herzog

FARM

COMPANY

Petroleum Inc.

CONTRACTOR

Garvey

Wildcat


Ft. from N. Line

Ft. from S. Line

Ft. from E. Line

Ft. from W. Line

NW SW NE

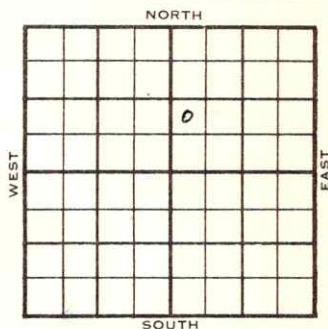

1955

ELEVATION

1747'

REPORT

10/12

R U R

11/2

Comm 10-11-55

8 5/8" @ 225/150

H 2768

Dg 2797

Bl 2887

L 2908

BKC 3155

C 3224

S 3244

A 3246

TD 3264

DST 3247-53 open 1 1/2 hr rec 15' mud

150/20" DST 3253-59 open 1/2 hr

rec 20' so & gcm 750/20" DST

3258-64 open 1 hr rec 60' muddy

oil 900/20" 5 1/2" @ 3255/50

CO to 3264 1 bfph 5% wtr SP 3261

250 A 12 gfph 40% wtr 250 A

2 bfph 86% wtr

D & A

501 TICKET

DX-201

SEC.

22

TWP.

18

R.

10W

WELL NO.

2 Herzog

FARM

COMPANY

Petroleum Inc.

CONTRACTOR

CORRECTION

NW SWNE

FT. FROM N. LINE


990

FT. FROM S. LINE

FT. FORM E. LINE

330

FT. FROM W. LINE

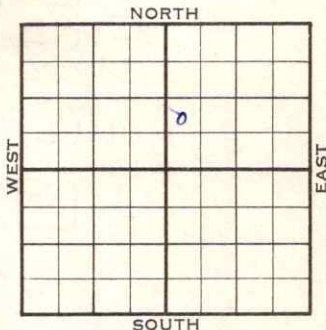

Rice County

☐

LOCATION

☐

RIG UP

DRILLING AND REMARKS:

Reported
#1 Herzog

RECORD

CASED IN., FT.

SAND

GAS

OIL

TOTAL DEPTH

PRODUCTION

1ST 24 HRS. NAT.

1ST 24 HRS. AFTER SHOT

GAS CU. FT.

DRY HOLE

ABANDONED

DATE

OCT 19 1955

SCOUT

L. J. Harris

County Rice Elev. _____
 Sec. 22 Twp. 18 Rge. 10W
 Company Petroleum Inc.
 Farm Name Herzog No. 1

TOPS	DEPTH	LOG	DATUM	Loc. in Sec.
Anh.				NW SW NE
Tp.				
H.				
Tr.				
Dg.				
Bl.				
L.				
K.C.				Geol.
B.K.C.				Contr.
Ce.				<u>Garvey</u>
C.				Pool
M.				<u>Wildcat</u>
M.				
K.				
Mz.				
Me.				
V.				
S.				
S.				
A.				
R.				
Pe.				
G.				
T.D.				



Date Comm.

R U R

Co.

Lse.

No.

Sec.

T.

R.

County Rice Elev. 1747
 Sec. 22 Twp. 18 Rge. LOW
 Company Petroleum Inc.
 Farm Name Herzog No. 2

TOPS	DEPTH	LOG	DATUM	Loc. in Sec.
Anh.				NW SW NE
Tr.				
H.	2768		1021	
Dg.	2797		1050	
Bl.	2887		1140	
L.	2908		1161	
K.C.				Geol.
B.K.C.	3155		1408	
Ce.				Contr.
C.	3224		1477	Garvey
M.				
M.				Pool
K.				Orth
Mz.				
Me.				
V.				
S.	3244		1497	
S.				
A.	3246		1499	
R.				
Pe.				
G.				
T.D.	3264			



Date Comm. 10-11-55 NOV 2 1955
 8 5/8" @ 225/150 DST 3247-53 open 1/2 hr
 rec. 15' mud 150/20" DST 3253-59
 open 1/2 hr. rec. 20' so & gcm 750/20"
 DST 3258-64 open 1 hr. rec. 60' muddy
 oil 900/20" 5 1/2" @ 3255/50
 CO to 3264 1 bfph 5% wtr. SP 3261
 250 A 12 gfph 40% wtr. 250 A
 2 bfph 86% wtr.

D. & A