

Rice

DX 78-1

KANSAS

Section 23 Township 18 Range 10W


Well No. #1 Salem Church

Company Harms & Burt Drlg.

NORTH

WEST

EAST

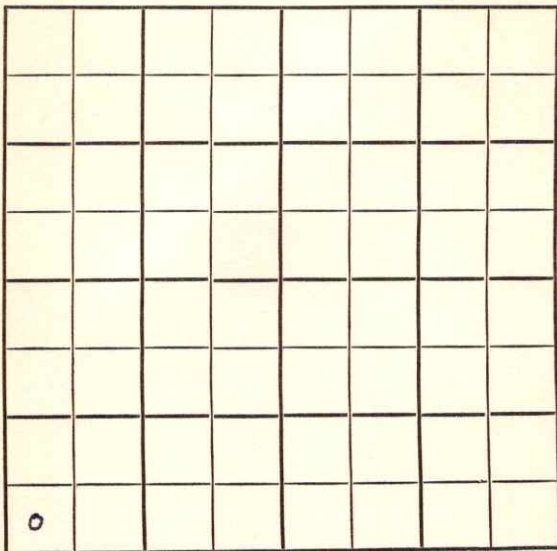

SOUTH

# Rice KANSAS

|      |      |     |
|------|------|-----|
| SEC. | TWP. | R.  |
| 23   | 18   | 10W |

WELL NO.

1 Salem Church

FARM

COMPANY

Harms & Burt Drlg.

CONTRACTOR

Co. Tools

Orth Pool


\_\_\_\_\_ Ft. from N. Line

330 \_\_\_\_\_ Ft. from S. Line

\_\_\_\_\_ Ft. from E. Line

330 \_\_\_\_\_ Ft. from W. Line

SW SW SW

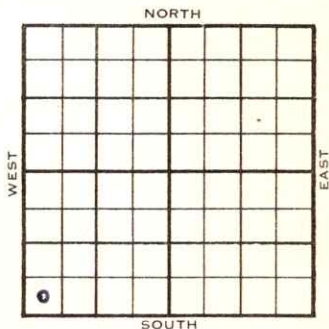

|      | ELEVATION   | REPORT |
|------|---|--------|
| 1954 | 1752'   |        |
| 10/6 | Spud 10-2-54<br>8" @ 162'<br>Drlg. 220'   |        |
| 11/3 | Spud 10-2-54<br>D & A<br>TD 3278'<br>8" @ 162'<br>Top 2525', Heeb 2782', Doug sh. 2812'<br>Doug sd. 2833', Br. Lime 2905', KC<br>2931', B KC 3195', Cong 3234' Arb 3267'<br>DST 3268'-72' opn 1 hr, rec 120' gas,<br>35' o & gcm, 965#<br>TD 3272'<br>5" @ 3268'<br>CO to 3272' B/ 1/2 boph DD 3273<br>500 A B/ 1/2 boph sd-oil-frac DD 3278<br>1000 A FU 2000' wtr.<br>D & A |        |

ABANDONED

County **Rice** State **Kansas**

Sec. **23** (Bk. **18** (Sur. **10W** Map No.

Operator **Harms & Burt Drlg.**

Well No. **1** Farm **Salem Church**

| Elev. | Location | SW SW SW |
|-------|----------|----------|
|       |          |          |

0

FIRST REPORT

330 Ft. From S Line SW

330 Ft. From  Line Quarter

1st. Report OCT 6 1954

### Completion

Remarks

Co. tools

Spudding Date 10-2-54

Orth Pool  
Drlg. Data

8" @ 162 drlg. 220

FABEN GILSTRAP

County Rice State KansasSec. 23 (Blk.  
Twp.) 18 (Sur.  
Rge.) 10W Map No.Operator Harms & Burt Drlg.Well No. 1 Farm Salem ChurchElev. 1752 Location SW SW SW330 Ft. From S Line SW330 Ft. From W Line Quarter

1st. Report

Completion NOV 3 1954Remarks Orth PoolCo. toolsSpudding Date 10-2-54Drlg. Data D & A TD 32788" @ 162 Top. 2525 Heeb. 2782Doug. sh. 2812 Doug. sd. 2833 Br. lime2905 KC 2931 B KC 3195 Cong. 3234Arb. 3267 DST 3268-72 open 1 hr.Rec. 120' gas 35' o & gcm 965#TD 3272 5" @ 3268 CO to 3272 B/  $\frac{1}{2}$  bophDD 3273 500 A B/  $\frac{1}{2}$  boph sd-oil=fracDD 3278 1000 A FU 2000' wtr.D & A

FABEN GILSTRAP