


Section 21 Township 18 Range 10 W

Well No. # 6 Bieberle

Company I. W. Murfin

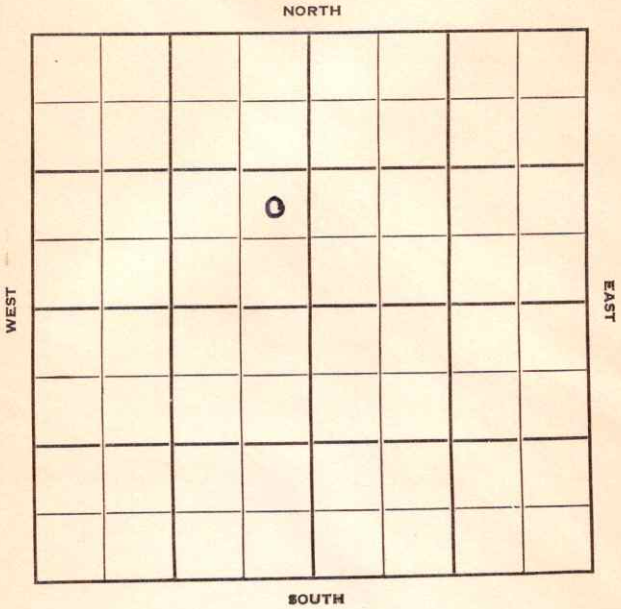

Rice

KANSAS

Sec. 21 Twp. 18 R. 10W

Well No. #6 Bieberle Farm

I. W. Murfin Company


Murfin Drlg. - Contr. Contractor

..... Ft. from N. Line

990' Ft. from S. Line

330' Ft. from E. Line

..... Ft. from W. Line

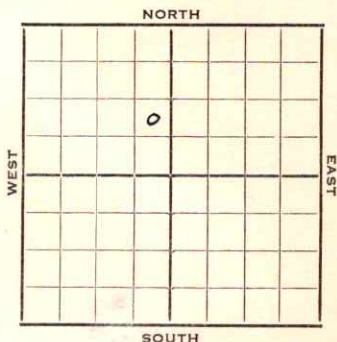

NE SE NW

1952

Elev. 1746' REPORT

4/23 Spud 4-14-52
Drlg. 2000'

4/30 **Topeka 2498 Heeb. 2762**
Douglas 2798 Br Li 2881
Lans. 2901 Cong. 3203
Arb. 3230 RTD 3239
5" @ 3232'

5/7 WOCT

5/14 Drlg. 3243'

5/21 DP

5/28 DD 3245' TD S/ 6 Boph 500 A
S/ 9 Boph POP

6/4 Spud 4-14-52
Oil Well TD 3245
Top 2498 Heeb. 2762 Doug 2798
Br Lime 2881 Lans. 2901 Cong. 3203
Arb. 3230 TD 3239 5" @ 3232
DD 3245 S/6 boph 500 A S/9 boph
Comp. 40 bopd

COMPLETED

