

KANSAS

Rice

Sec. 22 Twp. 18 R. 10-W

Well No. #1 Bieberle Farm

Artnell Company

Habiger Pool


_____ Ft. from N. Line

330' Ft. from S. Line

_____ Ft. from E. Line

1090' Ft. from W. Line

SE SW SW

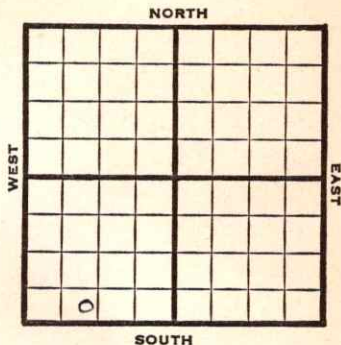

1947 **Elev. 1753'** REPORT

11/12 RUR

11/19 10" @ 243'
Drlg. 1650'

11/25 **Topeka 2480'**
Heebner 2745'
TD 2760'
7" @ 2760'
RUST

12/3 40 shots 2692-2699
CO

12/10 "

12/30 **Topeka 2480'**
7" @ 2760'
Heeb 2745'
PIPE Collapsed
TD 2760'

ABANDONED

Map No. _____ Sec. 22 Twp. 18 R. 10W

Well No. 1 Bieberle

Artnell Company

FIRST REPORT

Contractor

SE SW SW


SECTION PLAT

_____ Ft. from N. Line

330 Ft. from S. Line

_____ Ft. from E. Line

1090 Ft. from W. Line

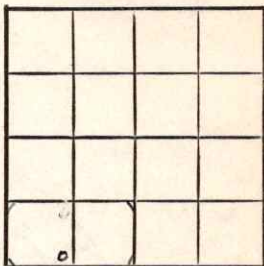

Rice County

Location _____

Rig up _____

Drilling and Remarks:

R U R

RECORD

Cased _____ in., _____ ft.

Sand _____

Gas _____

Oil _____

Total Depth _____

PRODUCTION

1st 24 hrs. Nat. _____

1st 24 hrs. after shot _____

Gas _____ Cu. Ft.

Dry Hole _____

Abandoned _____

Date

NOV 1 2 1947 19

S. J. LEWIS Scout

