

Sec. 20 Twp. _____

O.W.D.D.

13W

Well No. #4 Rogg (C) Farm _____

Shields Oil Prod. Company _____

Shields Contractor _____


_____ Ft. from N. Line

330 _____ Ft. from S. Line

_____ Ft. from E. Line

990 _____ Ft. from W. Line

SE SW SE

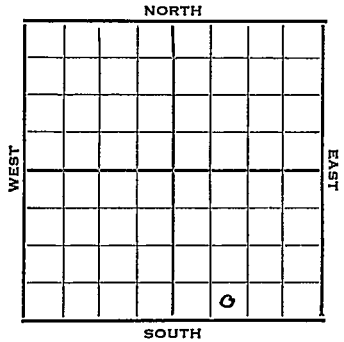

1952 Elev. 1772' REPORT

5/7 Cable tools
 5/14 15" @ 56' 12" @ 435 Anhy 725'
 Drlg. 805'
 5/21 10" @ 733 Drlg. 1750
 5/28 Indian Cave sd 1993-2002' HF oil
 F wild for 3 hrs. TD 2013' PB 1993'
 8" @ 1993' WOC
 6/4 Spud 5-7-52
 Oil Well TD 2013
 15" @ 56 12" @ 435
 Anhy. 725' 10" @ 733
 Indian Cave 1993-2002
 HFO F/wild for 3 hr. TD 2013
 PB 1993 8" @ 1993 DP to 2013
 S/7 boph Comp. 25 bopd

COMPLETED

1953 O.W.D.D.

6/10 Indian Cave Sd 1993-2013 OTD DD
 7" @ 2098'
 SO 2160-65 1st Tarkio 2295
 30 go 1 hr. 2nd Tarkio sd 2308-25
 5" @ 2321'

OVER

1953

#4 Rogg "C"

6/17 Oil Well
TD 2321'
Indian Cave Sd 1993-2002
7" @ 2098'
SO 2160-65 1st Tarkio 2295, 30 go
1 hr. 2nd Tarkio 2308-25
5" @ 2321
TD 2321'
CO to TD
24/ 2279-81 36/ 2285-88
Hydro S/ 5 boph 18 hr.
Comp. 25 bopd.

COMPLETED

