KANSAS


Form 51—5M—7-39—Palace

Russell

Section 35 Township 14 Range 13-W

Well No. #3 Lipprand

Company Texon

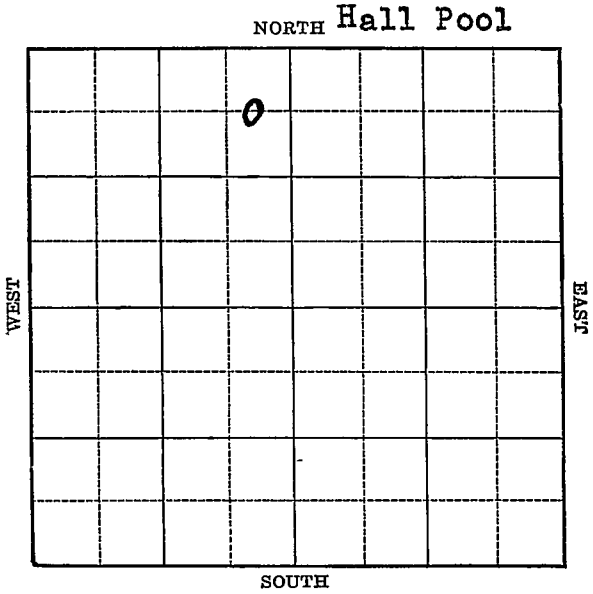

FORM 252-A 5M 2-40

KANSAS Russell

Sec. 35 Twp. 14 R. 13-W

Well No. #3 Lipprand Farm

Texon Company

(Hall)


660 Ft. from N. Line

Ft. from S. Line

330 Ft. from E. Line

Ft. from W. Line

Elev. 1688

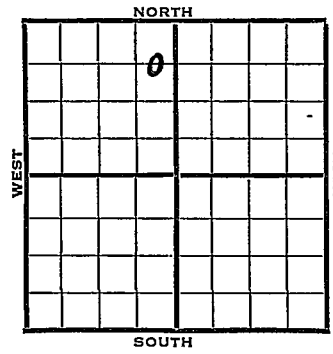

1940	REPORT
3/20	10" - 335' WOC.
3/28	Drlg. 2800'
4/4	Lans. 2808' 6" - 2822'
	T.D. 2859' 1500' oil. C.O.
4/10	Lansing 2808'
	T.D. 2861'
	7000 acid.
	Pump 1219 bbls.
	COMPLETED

Form 26—1M Bks.—2-29 Russell KANSAS

Map No. 72 Sec. 35 Twp. 14 R. 13W

Well No. 3 Lipprand

Texon Company

Contractor

FIRST REPORT

C E L NE NW

660 Ft. from N. Line


Ft. from S. Line

330 Ft. from E. Line

Ft. from W. Line

HALL POOL

SECTION PLAT

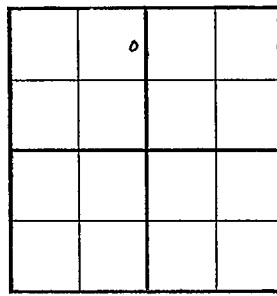

Location

Rig up

Drilling and Remarks:

10" @ 335

WOC

RECORD

Cased in., ft.

Sand

Gas

Oil

Total Depth

PRODUCTION

1st 24 hrs. Nat.

1st 24 hrs. after shot

Gas Cu. Ft.

Dry Hole

Abandoned

Date

MAR 20 1940 19 S. J. LEWIS Scout

Form 26—200 Bks.—1-40—Palace Russell KANSAS

Map No. 72 Sec. 35 Twp. 14 R. 13W

Well No. 3 Lipprand

Texon Company

Contractor

COMPLETED

C E L NE NW

660 Ft. from N. Line


Ft. from S. Line

330 Ft. from E. Line

Ft. from W. Line

HALL POOL

SECTION PLAT

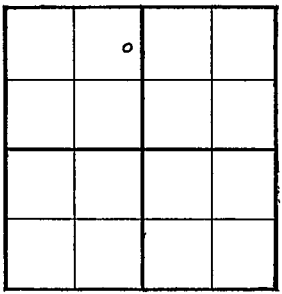

Location

Rig up

Drilling and Remarks:

7000 acid

1219 bbls

pump

RECORD

Cased in., ft.

~~Sand~~ Lansing 2808

Gas

Oil

Total Depth 2861

PRODUCTION

1st 24 hrs. Nat.

1st 24 hrs. after shot

Gas Cu. Ft.

Dry Hole

Abandoned

Date

APR 10 1940 19 S. J. LEWIS Scout