


Section 25 Township 14 Range 13 W

Well No. # 2 Weinmeister

Company Keystone Drlg.

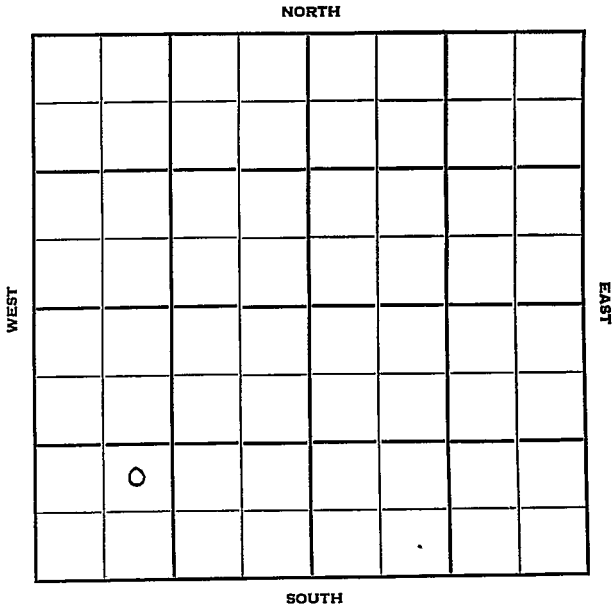

Sec. 25 Twp. 14 R. 13 W ✓

Well No. # 2 Weinmeister Farm

Keystone Drlg. Company

Contractor

Hall-Gurney Pool


Ft. from N. Line

990 Ft. from S. Line

Ft. from E. Line

990 Ft. from W. Line

NE SW SW

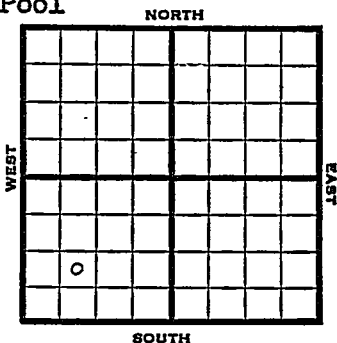

1951

Elev. 1685' REPORT

5/2

Spud 4-23-51
13" @ 305' 10" @ 608'
Drlg. 625'

6/20

Spud 4-23-51
Oil Well TD 2192
13" @ 305 10" @ 608
8" @ 625
Tarkio 2183-92
7" @ 2186 B/3-4 boph
Comp. 60 bopd

COMPLETED

