


Kingman

KANSAS

SECTION 15 TOWNSHIP 30 RANGE 7 W

WELL NO. #1 Gilchrist

COMPANY Wilcox Oil

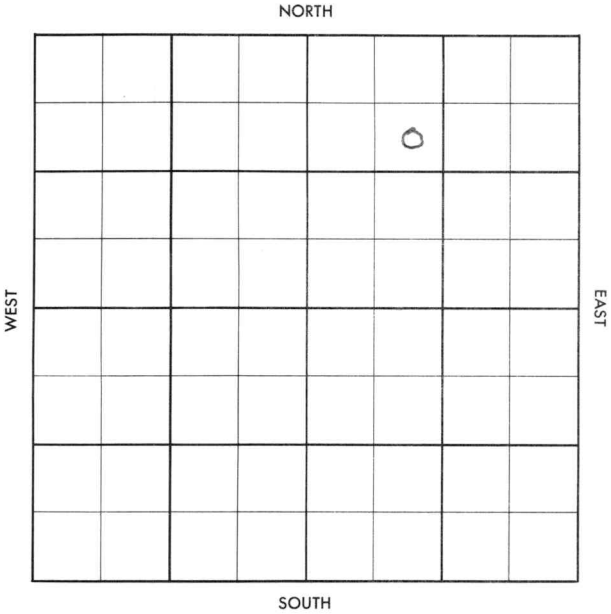

Kingman

KANSAS

SEC.	TWP.	R.
15	30	7 W

WELL NO.

1 Gilchrist

FARM

COMPANY

Wilcox Oil

CONTRACTOR

D & M


Wildcat

Ft. from N. Line

Ft. from S. Line

Ft. from E. Line

Ft. from W. Line

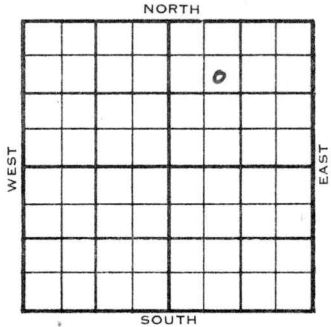

SE NW NE

SDX - 1/2 Mile

Pure - DHM

ELEVATION

REPORT

1955

11/23

Comm. 11-19-55
8" @ 161/150
Drlg. 1345'

12-1

KC 3548
Drlg. 3614'

12-8

DST 3715-29, op 45 min. gas in 10 min.,
rec. 930' gassy oil, 1600/15"
DST 3730-40, op 1½ hr. gas in 7 min.,
rec. 40' ho&gcm, 1050' gassy oil, 210'
msw, 1520/20"
DST 4085-98, op 1 hr. gas in 25 min.,
rec. 70' gcm, 870/20"
DST 4101-15, op 1 hr. gas in 7 min.,
145 mcfg in 15 min., 189 mcfg in 30min.
rec. 120' gcm, 1520/20"

12-15

5½" @ 4171/200
20/ 3726-31,
FU 135' oil 1 hr., 500 A
F/ 80 bo 2 hrs.
F/ 316 bo 16 hrs.

12-22

Waiting on potential

12-29

F/ 155 BO 18 hrs.

1956

F/ 55 BO 9 hrs.

1-6

Waiting on potential

1-12

" " "

1-19

F/ 100 bo 12 hrs.

DX-78

1-26

No report

2-2 No report
208 "

County Kingman Elev. _____
 Sec. 15 Twp. 30 Rge. 7W
 Company Wilcox Oil
 Farm Name Gilchrist No. 1

TOPS	DEPTH	LOG	DATUM	Loc. in Sec.
Anh.				SE NW NE
TP.				
H.				
Tr.				
Dg.				
BL.				
L.				Geol.
K.C.				Contr.
B.K.C.				D & M
Ce.				Pool
C.				Wildcat
M.				
M.				
K.				
Mz.				
Mq.				
V.				
S.				
S.				
A.				
R.				
PE.				
G.				
T.D.				

Date Comm. 11-19-55 Pure - DHM

8" @ 161/150 drlg. 1345

27

County Kirkman Elev. 1429
 Sec. 15 Twp. 30 Rge. TN
 Company Gilco Oil
 Farm Name Gilchrist No. 1

TOPS	DEPTH	LOG	DATUM	Loc. in Sec.
Ant.				SE NW NE
Tr.				
Dg.				
Bl.				
L.		3263	1934	Geol.
K.C.	3548	3536	2117	Contr.
B.C.		3793	2364	
C.		3985	2556	
M.	4075	4083	2654	Gilchrist
M.				Pool
K.				
Mz.				
Mo.				
V.				
S.				
A.				
R.				
PE.				
G.				
TD	4178			

Date Comm. 11-12-55 Wire - 000

8" @ 161/150 drs. 1345 NOV 30 '55 03614

DEC 7 '55 DST 3715-29 45"

9 in 10" rec 930' G54 oil

BHP 1600/15 DST 3730-40

90" G in 7" rec 40' H08 GCM

+1050' G54 oil 210' MSW

FP 260-540 BHP 1520/20

DST 4085-98 rec 1 in 25"

rec 70' GCM FP 0 BHP 870/20

COMPLETE

FEB 15 1956

DST 4101-4115 1 hr 9 in 7"
9a 145 MCF in 15" 189 MCF
in 30" net 120' GCM FPO
BHP 1520/20" DEC 14 '55 5 1/2 4171
1200 20/3726-31 FU 135'
oil 1 hr 1 1/2 Flw 80 BO
2 hrs (\$ in hole) Flw 316
BO in 16 hrs 19/64" cs9 ch"
SICP 375# DEC 21 '55 S. I. WOPOT
DEC 28 '55 Flw 155 BO 18 hrs
14/64" ch EP 120 SIP 360
Flw 55 BO in 9 hrs 12/64" ch
EP 140 SIP 380 JAN 5 '56 WOPOT
JAN 11 '56 ✓ JAN 18 '56 Flw 100 BO
12 hrs 12/64" ch. JAN 25 '56 ✓ FEB 1 '56 ✓
FEB 8 '56 ✓ FEB 15 '56 Ph Flw 444 BOPD
+ Tr wtr grav 39°

R.G.

FEB 27 1958