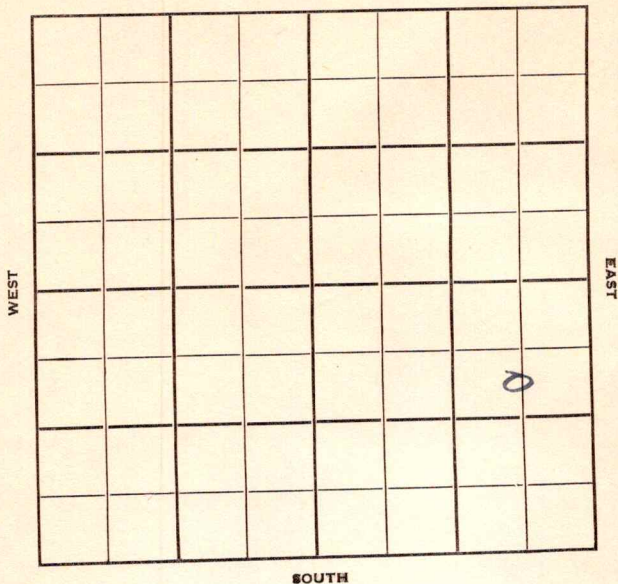


KANSAS

Ellsworth

Section 3 Township 17 Range 10WWell No. 2 SiemsenCompany B & R Drlg.Stoltenberg
NORTH

HOT FILE KANSAS EllsworthSec. 3 Twp. 17 R. 10WWell No. #2 Siemsen Farm


B & R Drlg.

Company

Stoltenberg Pool (B & R Drlg. Cont.)

990' Ft. from N. Line Ft. from S. Line660' Ft. from E. Line Ft. from W. Line

C S L NE SE

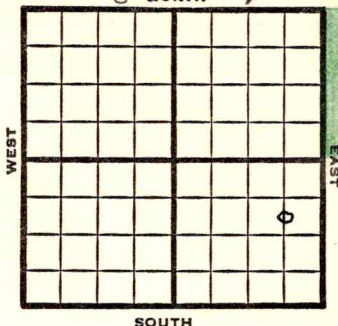

1949

Elev 1789'

REPORT

9/14

8" 378'

Anhy 543'

Drlg. 1650'

9/21

Lansing 2924'**Arbuckle 3270'**

Drlg. 3285'

9/28

Granite wash 3716'

TD 3813'

5"@ 3400'

SWD

10/5

"

10/12

"

10/19

TD 3813'

Granite Wash 3716'

5"@ 3400'

4000 acid

SWD

Abandoned

ABANDONED

Map No. K55 Sec. 3 Twp. 17 R. 10W

Well No. 2 Siemsen

B & R Drlg. Company

B & R Drlg. Contractor

C S L NE SE


SECTION PLAT

990 Ft. from N. Line

Ft. from S. Line

660 Ft. from E. Line

Ft. from W. Line

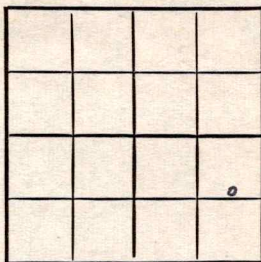

Ellsworth County

Location

Rig up

Drilling and Remarks:

8" @ 378

Anhy 543

drlg. 1650

RECORD

Cased in, ft.

Sand

Gas

Oil

Total Depth

PRODUCTION

1st 24 hrs. Nat.

1st 24 hrs. after shot

Gas Cu. Ft.

Dry Hole

Abandoned

Date

Map No. _____ Sec. 3 Twp. 17 R. 10W

Well No. 2 Siemsen

B & R Drlg.

Company

ABANDONED

Contractor

C S L NE SE


E. 11789
SECTION PLAT

990 Ft. from N. Line

_____ Ft. from S. Line

660 Ft. from E. Line

_____ Ft. from W. Line

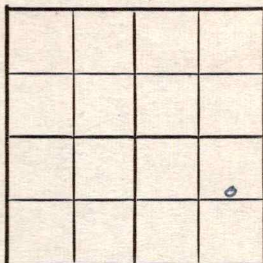

Ellsworth County

RECORD

Location _____

Cased _____ in., _____ ft.

Rig up _____

Sand _____

Drilling and Remarks:

Gas _____

Oil _____

Total Depth 3872

PRODUCTION

1st 24 hrs. Nat. _____

1st 24 hrs. after shot _____

Gas _____ Cu. Ft.

Dry Hole _____

Abandoned _____

Date

OCT 19 1949

19

S. J. LEWIS

Scout