


Russell

Form 51—5M—11-38—Palace

Section 33 Township 13 Range 15-W

Well No. 5 Mills "B"

Company Bridgeport Machine

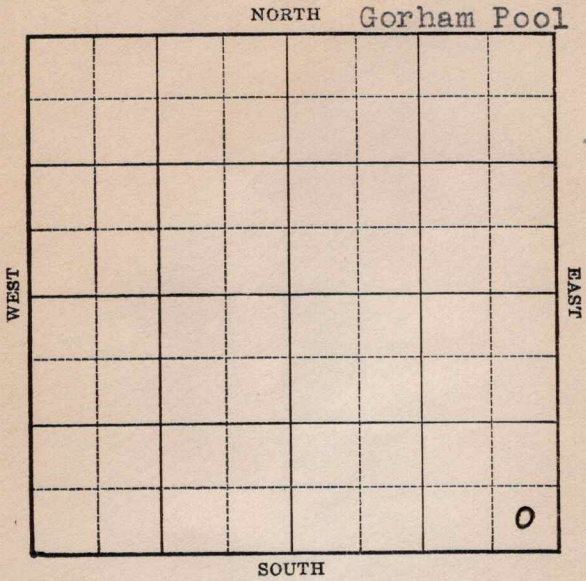


KANSAS

Russell

Sec. 33 Twp. 13 R. 15-WWell No. #5 Mills "B" FarmBridgeport Machine Company

(Gorham)

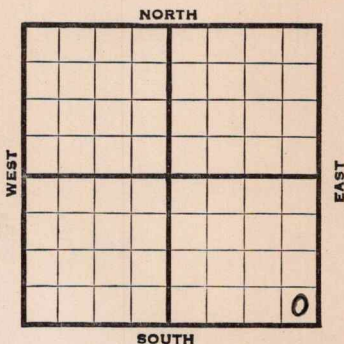 Ft. from N. Line330 Ft. from S. Line330 Ft. from E. Line Ft. from W. Line

Elev. 1896'

1939

REPORT

4/5	B.C.R.
4/14	C.R.
4/21	"
4/28	"
5/5	Rigging up.
5/12	Spud.
5/19	15" - 385' T.D. 465' Run 13".
5/26	13" - 580' 10" - 937'
	Anhy 934' Drlg. 1275'
6/1	Drlg. 2235'
6/8	8" - 2580' Drlg. 2870'
6/16	Lans. 3045' Drlg. 3205'
6/21	Granite 3347'
	T.D. 3350'

ABANDONED

Russell

KANSAS

Map No. 72 Sec. 33 Twp. 13 R. 15WWell No. 5 Mills "B"

Bridgeport Machine

Company

Contractor

FIRST REPORT

SE/C

SECTION PLAT

			0

 Ft. from N. Line330 Ft. from S. Line330 Ft. from E. Line Ft. from W. Line

GORHAM POOL

Location Rig up

Drilling and Remarks:

BCR

RECORD

Cased in., ft.Sand Gas Oil Total Depth

PRODUCTION

1st 24 hrs. Nat. 1st 24 hrs. after shot Gas Cu. Ft.Dry Hole Abandoned

Date

APR 5 - 1928

19

H. D. Hatfield Scout

Russell

KANSAS

Map No. _____ Sec. 33 Twp. 13 R. 15WWell No. 5 Mills "B"Bridgeport

Company _____

Contractor _____

ABANDONED
SE/C

_____ Ft. from N. Line

330 Ft. from S. Line330 Ft. from E. Line

_____ Ft. from W. Line

GORHAM POOL

SECTION PLAT

			o

Location _____

Rig up _____

Drilling and Remarks:

Granite 3347

RECORD

Cased _____ in., _____ ft.

Sand _____

Gas _____

Oil _____

Total Depth 3350

PRODUCTION

1st 24 hrs. Nat. _____

1st 24 hrs. after shot _____

Gas _____ Cu. Ft.

Dry Hole _____

Abandoned _____

Date

JUN 21 1939

19

S. J. LEWIS

Scout