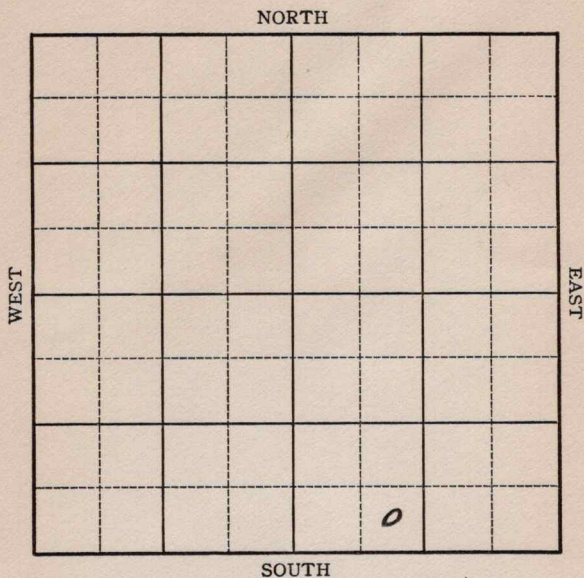


Russell

KANSAS

Section 34 Township 13 Range 15-WWell No. #1 BaierCompany H. Witt

738468

1937

11/10 5" liner 3322'.

6" @ 3319'.

Sil. 3323'.

T.D. 3336'.

1500 acid.

2600' water.

ABANDONED


Russell KANSAS

Map No. 72 Sec. 34 Twp. 13 R. 15WWell No. 1-BaierH Witt Company

Contractor

FIRST REPORT

SECTION PLAT

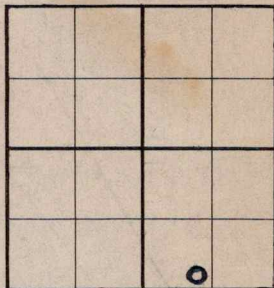 Ft. from N. Line330 Ft. from S. Line Ft. from E. Line990 Ft. from W. LineLocation Rig up

Drilling and Remarks:

Rig up Cable Tools

RECORD

Cased in., ft.Sand Gas Oil Total Depth

PRODUCTION

1st 24 hrs. Nat. 1st 24 hrs. after shot Gas Cu. Ft.Dry Hole Abandoned

Date

SEP 22 1937

19

H. D. Hatfield

Scout

Russell **KANSAS**Map No. 72 Sec. 34 Twp. 13 R. 15WWell No. 1 BaierH. Witt

Company

Contractor

ABANDONED

SE SW SE

 Ft. from N. Line330 Ft. from S. Line Ft. from E. Line990 Ft. from W. Line

SECTION PLAT

		0	

Location Rig up

Drilling and Remarks:

1500 acid
2600' water

*D & A**5" Liner 3322*

RECORD

Cased 6 in., 3319 ft.Sand 51/ 3323Gas Oil Total Depth 3336

PRODUCTION

1st 24 hrs. Nat. 1st 24 hrs. after shot Gas Cu. Ft.Dry Hole Abandoned

Date

NOV 10 1937

19

H. D. Hatfield

Scout