
Russell

Form 51—5M—5-34—Palace

Map No. KANSAS Sec. 35 Twp. 13 R. 15W

Well No. 1 Baier Farm

Hartman & Blair Company

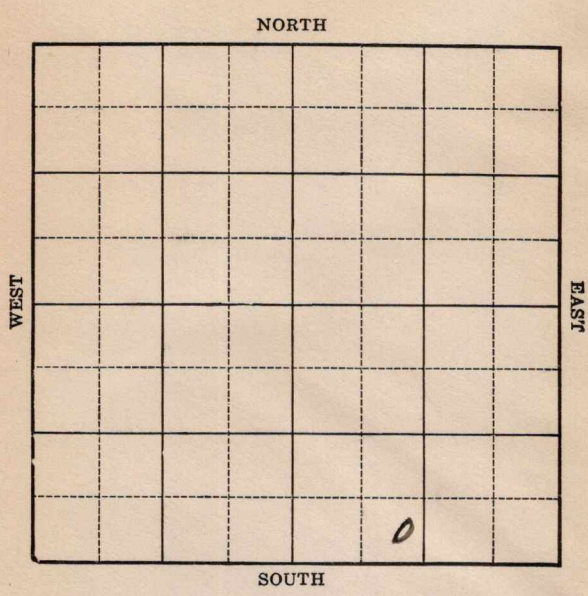

Location

Drilling Remarks

Rig Up

Drilling Remarks

RECORD

Cased ____ in. ____ ft.

Sand

Gas

Oil

Total Depth

PRODUCTION

1st 24 hrs. Nat.

1st 24 hrs. after shot

Gas ____ cu. ft.

Dry Hole

Abandoned


Form 252-A
5M 7-34 MPC

Russell

Map No. KANSAS Sec. 35 Twp. 13 R. 15W

Well No. 1- Baier Farm

Hartman & Blair Company

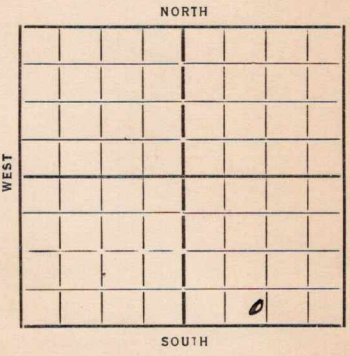

_____ Ft. from N. Line

330 Ft. from S. Line

1570 Ft. from E. Line

_____ Ft. from W. Line

Date 1935	REPORT
5/1	Cellar
5/9	BR
5/16	Rig
5/23	— 5/29 —
6/6	Spud & SJ.
6/13	— 12" 546
6/30	Dly 1185 10" 930
6/28	" 2275
7/3	8" 2840 to 2780-90
	Dly 2910
7/11	Oswald 3064 6" 3064
	to. 3090 W. 3100-10
	W R 6" 3228
7/18	Sil 3310-15 TD 3000 Sil
	6" 3312
7/31	Top Siliceous 3310
	T.D. 3315
	426 oil

COMPLETED

Form 26—1M Blks.—9-28 Russell KANSAS

Map No. 72 Sec. 35 Twp. 13 R. 15W


Well No. 1—Baier

Hartman & Blair Company

Contractor

FIRST REPORTS

SECTION PLAT

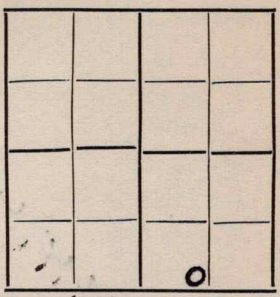

Ft. from N. Line

330 Ft. from S. Line

1570 Ft. from E. Line

Ft. from W. Line

Location

Rig up

Drilling and Remarks:

cellar

RECORD

Cased in., ft.

Sand

Gas

Oil

Total Depth

PRODUCTION

1st 24 hrs. Nat.

1st 24 hrs. after shot

Gas Cu. Ft.

Dry Hole

Abandoned

Date

5-1-35 192

ORVAL MANNSCHRECK Scout

Form 26—1M Bks.—9-28

Revised

Map No. 72 Sec. 35 Twp. 13 R. 15W


Well No. 1- Baier

Hartman & Blair Company

Contractor

COMPLETED

SECTION PLAT

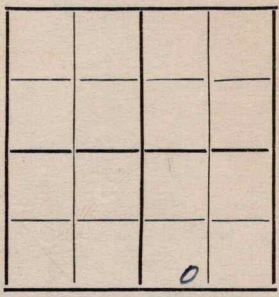

Ft. from N. Line

330 Ft. from S. Line

1570 Ft. from E. Line

Ft. from W. Line

Location

Rig up

Drilling and Remarks:

426 bbls

RECORD

Cased ... in., ... ft.

Sand Sil 3310

Gas

Oil

Total Depth 3315

PRODUCTION

1st 24 hrs. Nat.

1st 24 hrs. after shot

Gas ... Cu. Ft.

Dry Hole

Abandoned

Date

7-31-35 192...

ORVAL MANNSCHRECK

Scout