

Ellis


KANSAS

SECTION 20 TOWNSHIP 11S RANGE 17W

WELL NO. #4 Hadley "A"

COMPANY Murfin Drlg. Co.

NORTH <sup>SW</sup> NE NW NW

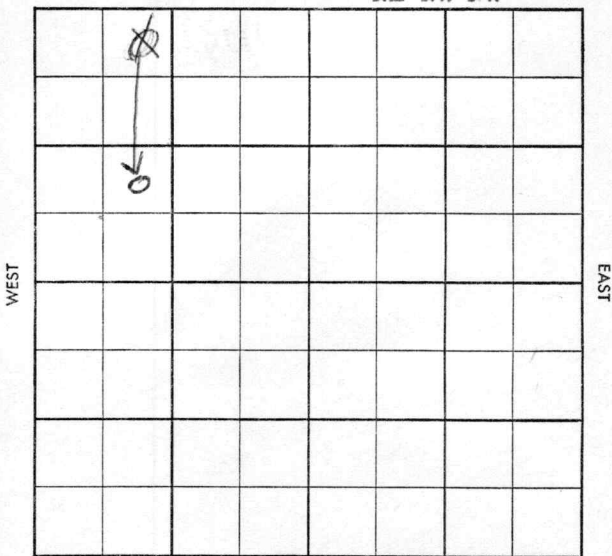

SOUTH

~~W.C. Pool~~ ~~Surrett~~  
~~W.C. Pool~~ ~~S~~

County Ellis Elev. \_\_\_\_\_  
 Sec. 20 Twp. 11 Rge. 17W  
 Company Murfin Drlg. Co.  
 Farm Name Hadley "A" No. 4

TOPS	DEPTH	LOG	DATUM
Anh.			
Tp.			
H.			
Tr.			
Dg.			
B.L.			
L.			
K.C.			
B.K.C.			
Ce.			
C.			
M.			
M.			
K.			
Mz.			
Mq.			
V.			
S.			
S.			
A.			
R.			
Pf.			
G.			
T.D.			

Loc. in Sec. \_\_\_\_\_  
NE NW NW  
 Geol. \_\_\_\_\_  
 Contr. \_\_\_\_\_  
Co. Tools  
 Pool \_\_\_\_\_  
Bemis-Shutts



Date Comm. 4/27/58  
8" @ 1167, WOC  
 \_\_\_\_\_  
 \_\_\_\_\_  
 \_\_\_\_\_  
 \_\_\_\_\_  
 \_\_\_\_\_  
 \_\_\_\_\_  
 \_\_\_\_\_

Co.  
Lse.  
No.  
Sec.  
T.  
R.

Twp. ~~X~~ Pcc. ~~X~~  
 Co. ~~X~~ Facet ~~X~~  
**CORRECTION**

S-513-B

County Ellis Elev. 1908 OF 1911 RE  
 Sec. 20 Twp. 11 Rge. 17W  
 Company Murfin Drlg. Co.  
 Farm Name Hadley "A" No. 4

TOPS	DEPTH	LOG	DATUM
Anh.	<u>1154</u>		
Tp.		<u>2959</u>	
H.		<u>3090</u>	
Tr.			
Dg.			
B.L.			
L.		<u>3132</u>	
K.C.			
B.K.C.			
Ce.			
C.			
M.			
M.			
K.			
Mz.			
Mq.			
V.			
S.			
S.			
A.	<u>3408</u>	<u>3408</u>	
R.			
Pf.			
G.			
T.D.	<u>3509</u>		

Loc. in Sec. NE 1/4 NW  
~~NE 1/4 NW~~  
~~NE 3/4 NW~~  
 Geol. \_\_\_\_\_  
 Contr. \_\_\_\_\_  
 Co. Tools \_\_\_\_\_  
 Pool Bemis-Shutts

**COMPLETE**  
 MAY 21 '58

Date Comm. 4/27/58  
8" @ 1167 WOC MAY 7 '58 @ 3500 MAY 14 '58  
Log 5 1/2" 3509 54/3409-17  
\$ 3 BOPD NW 3 hrs (1/2)  
\$ 11 BOPD NW NT pop MAY 21 '58  
exp 25 BOPD NW

Co.  
Lse.  
No.  
Sec.  
T.  
R.