

KANSAS

Russell


FORM 51 5M 10-41 PETROL

Section 35 Township 13 Range 15-W

Well No. #2 Baier

Company Stanolind

NORTH Dilliner Pool

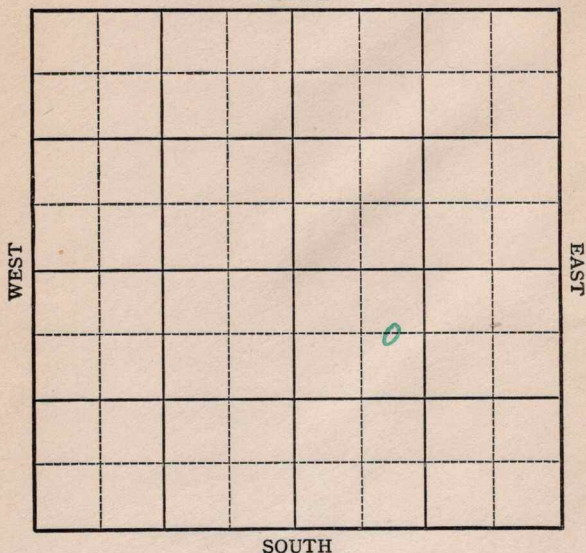

738474

1942

7/15

Arb. 3304'

7" - 3304'

T.D. 3311'

2000 acid.

Depthograph potential 592 oil & 17
water.

36. Gravity

COMPLETED

KANSAS

Russell

Map No. 72 Sec. 35 Twp. 13 R. 15WWell No. 2 Baier

Stanolind

Company

FIRST REPORT

Contractor

C EL NW SE

660 Ft. from N. Line

_____ Ft. from S. Line

_____ Ft. from E. Line

990 Ft. from W. Line

SECTION PLAT

		0	

DILLINER POOL

Location XX

Rig up _____

Drilling and Remarks:

RECORD

Cased _____ in., _____ ft.

Sand _____

Gas _____

Oil _____

Total Depth _____

PRODUCTION

1st 24 hrs. Nat. _____

1st 24 hrs. after shot _____

Gas _____ Cu. Ft.

Dry Hole _____

Abandoned _____

Date

APR 29 1942 19

S. J. LEWIS

Scout

Russell

KANSAS

Map No. 72 Sec. 35 Twp. 13 R. 15WWell No. 2 BaierStanolind

Company

COMPLETED

Contractor

C E L N W S E

SECTION PLAT

660 Ft. from N. Line

Ft. from S. Line

Ft. from E. Line

990 Ft. from W. Line

		6	

DILLINER POOL

Location

Rig up

Drilling and Remarks:

*Per 3304**7" @ 3304**2000 acid**Depth 3304 oil**+ 17 Water**360 Gr*

RECORD

Cased _____ in., _____ ft.

Sand _____

Gas _____

Oil _____

Total Depth 3311

PRODUCTION

1st 24 hrs. Nat. _____

1st 24 hrs. after shot _____

Gas _____ Cu. Ft.

Dry Hole _____

Abandoned _____

Date

JUL 15 1942 19S. J. LEWIS Scout