


KANSAS

Section 35 Township 13 Range 15W

Well No. 2 ~~7~~ Johnson

Company H. H. Blair ~~H. H. Blair Ashland Ref.~~

Russell Pool
NORTH

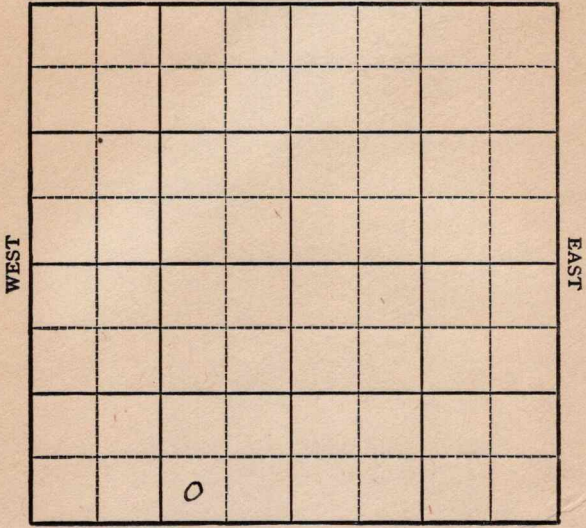

KANSAS

Russell



Sec. 35 Twp. 13 R. 15W

Well No. #1 Johnson Farm

~~Ashland Ref~~
~~H. H. Blair~~


Russell Pool H. H. BLAIR Company

_____ Ft. from N. Line

330' Ft. from S. Line

990' Ft. from E. Line

_____ Ft. from W. Line

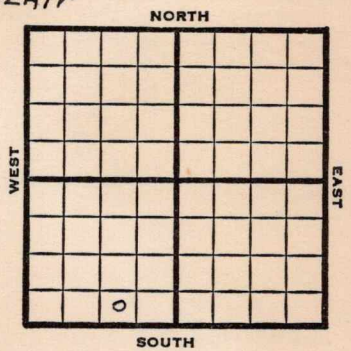

SW SE SW

1948

Eli 1906'

REPORT

10/20

8" @ 134'

Drlg. 617'

10/26

Drlg 2376'

11/3

Topeka 2739'

Lansing 3072'

Gorham 3327'

Arbuckle 3329

TD 3332'

5" @ 3329'

11/10

"

11/16

"

11/23

"

11/30

"

12/8

TD 3339'

1000 acid wtr.

plug 3185

8 shots 3152-59

10 shots 3135-45 CO

12/15

TD 3339'

Arb. 3329'

5 "@ 3329'

Aband.

ABANDONED

Map No. _____ Sec. 35 Twp. 13 R. 15W

Well No. 1 Johnson

H. H. Blair Company

FIRST REPORT Contractor

SW SE SW

SECTION PLAT

_____ Ft. from N. Line

330 Ft. from S. Line

990 Ft. from E. Line

_____ Ft. from W. Line

Russell County

Location _____

Rig up _____

Drilling and Remarks:

8" @ 134

drlg. 617

RECORD

Cased _____ in., _____ ft.

Sand _____

Gas _____

Oil _____

Total Depth _____

PRODUCTION

1st 24 hrs. Nat. _____

1st 24 hrs. after shot _____

Gas _____ Cu. Ft.

Dry Hole _____

Abandoned _____

Date

OCT 20 1948

19

S. J. LEWIS

Scout

