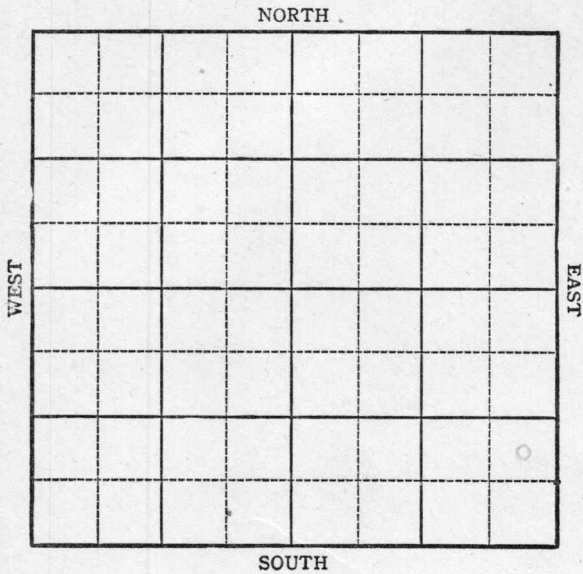


KANSAS

FORM 51 5M BRIX

Section 31 Township 16 Range 11WWell No. #1 JanssenCompany Kiowa Drlg.

KANSAS

Barton

Sec. 31 Twp. 16 R. 11W


Well No. #1 Janssen Farm

Kiowa Drlg.

Company

Kraft-Prusa

NORTH

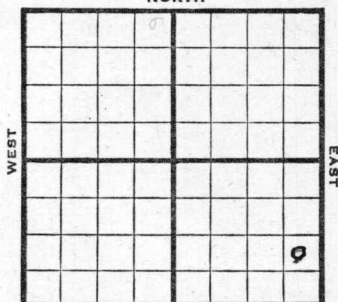

Ft. from N. Line

990 Ft. from S. Line

330 Ft. from E. Line

Ft. from W. Line

NE SE SE

Elm-1905

SOUTH

1945

R E P O R T

1/31

10" @ 287
Drlg 1835'

2/7

Drlg 3212

2/14

Lans 3083
Cong 3341
Arb 3361-77 TD
7" @ 3372 RUST

2/21

" " " "

2/28

" " " "

3/7

" " " "

3/14

TD 3384 - 10 Gals fluid per hr

3/23

TD 3405
25 shots 3184-3188½
500 acid.
20 shots 3184-3193 500 acid.

3/29

HFW PB

4/5

" "

4/12

6000 acid.
Swab 15 wtr. plus 10 oil in 8 hrs

4-18

Arbuckle 3361'
7" at 3372'
Total Depth 3405'

ABANDONED

KANSAS


Pool Name Kraft-PurusaMap No. 55 Sec. 31 Twp. 16 R. 11WWell No. 1 JanssenKiowa Drlg. Company

FIRST REPORT

Contractor

NE SE SE

SECTION PLAT

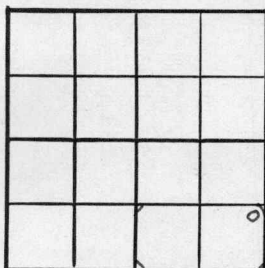 Ft. from N. Line990 Ft. from S. Line330 Ft. from E. Line Ft. from W. Line

Barton

Location Rig up

Drilling and Remarks:

10"-287

1835'

RECORD

Cased in., ft.Sand Gas Oil Total Depth

PRODUCTION

1st 24 hrs. Nat. 1st 24 hrs. after shot Gas Cu. Ft.Dry Hole Abandoned

Date

JAN 31 1945 19

S. J. LEWIS Scout

Kansas Pool Name Kraft-PrusaMap No. 55 Sec. 31 Twp. 16 R. 11WWell No. 1 JanssenKiowa Drlg. CompanyABANDONED Contractor

NE SE SE

E1, 1905
SECTION PLAT

			o

Ft. from N. Line990Ft. from S. Line330Ft. from E. LineFt. from W. LineBarton

Location _____

Rig up _____

Drilling and Remarks:

Cr X33617" C3392

RECORD

Cased _____ in., _____ ft.

Sand _____

Gas _____

Oil _____

Total Depth 8405

PRODUCTION

1st 24 hrs. Nat. _____

1st 24 hrs. after shot _____

Gas _____ Cu. Ft.

Dry Hole _____

Abandoned _____

Date

APR 18 1945

19

S. J. LEWIS Scout

First report on this well was spotted in the
NE SE SE. On this completion ticket you have
the well spotted in the NE NE NW.

Misc. Small Maps	
Cards	<i>Lozsky</i>
Tracing	<i>RL</i>
France Map	<i>11</i>
Scarborough Map	
Moody Map	<i>RL</i>
Geological Dept.	
Moody Plat Book	