

Russell


FORM 51 5M 4-41 PETROL

KANSAS

Section 35 Township 13 Range 15W

Well No. 1 Dilliner

Company Derby & Wakefield

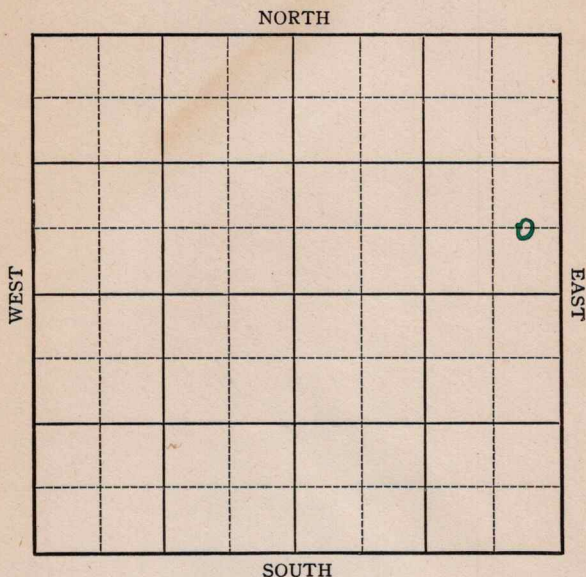


Sec. 35 Twp. 13 R. 15 -WWell No. #1 Dilliner FarmDerby & Wakefield Company

(Semi-Wildcat)

 Ft. from N. Line660 Ft. from S. Line330 Ft. from E. Line Ft. from W. Line

Elev. 1883

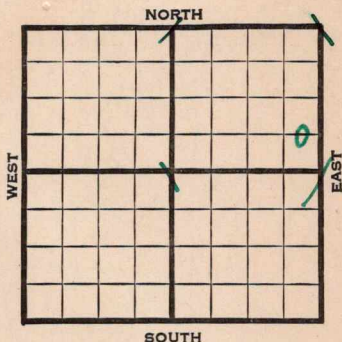

1941	REPORT
7/16	Drlg. 265'
7/24	15" @ 365 12" @ 610 Anhy 916 Drlg. 1155.
7/31	10" @ 941' Drlg. 2115'
8/7	2530' SD for pipe
8/15	SD for pipe.
8/21	8" - 2530' Lans. 3068'
	T.D. 3160' H.F.W. U.R. 6".
8/28	6" - 3178' Arb. 3322-25' T.D.
	500' oil 7½ hours. Run 5".
9/4	5" - 3322' 1100' oil 8 hours.
9/11	" " " " "
9/18	Shut down.
9/25	" "
10/2	" "
10/9	" "
10/16	" "
10/23	" "
10/30	" "
11/6	" "
11/13	" "
11/20	" "

OVER

738490

1941

11/26 T.D. 3325'
Shut down.

12/4 " "

12/11 " "

12/17 Arb. 3322

5" @ 3322

1000 acid

Pump 74 bbls. potential

SW

TD 3325

Grav. 36

COMPLETED

Map No. 72 Sec. 35 Twp. 13 R. 15WWell No. 1 DillinerDerby & Wakefield

Company

Contractor

FIRST REPORT


C E L S E N E

Ft. from N. Line

660 Ft. from S. Line330 Ft. from E. Line

Ft. from W. Line

SECTION PLAT

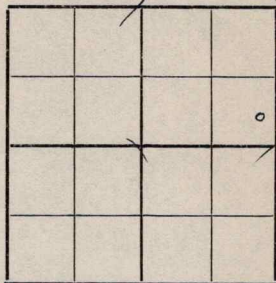

SEMI-WILDCAT

Location _____

Rig up _____

Drilling and Remarks:

Drlg. 265

RECORD

Cased _____ in., _____ ft.

Sand _____

Gas _____

Oil _____

Total Depth _____

PRODUCTION

1st 24 hrs. Nat. _____

1st 24 hrs. after shot _____

Gas _____ Cu. Ft.

Dry Hole _____

Abandoned _____

Date

JUL 16 1941 19S. J. LEWIS Scout

Russell

KANSAS

Map No. 22 Sec. 35 Twp. 13 R. 15WWell No. 1 DillinerDerby & Wakefield

Company

COMPLETED

Contractor

C E L S E N E

SECTION PLAT

			o

_____ Ft. from N. Line

660 Ft. from S. Line330 Ft. from E. Line

_____ Ft. from W. Line

SEMI-WILDCAT

Location _____

Rig up _____

Drilling and Remarks:

*CR Y 3322**5' 03322.**1000 acial**Pump 74 P.D.**B.W.**360 Gr.*

RECORD

Cased _____ in., _____ ft.

Sand _____

Gas _____

Oil _____

Total Depth 3325.

PRODUCTION

1st 24 hrs. Nat. _____

1st 24 hrs. after shot _____

Gas _____ Cu. Ft.

Dry Hole _____

Abandoned _____

Date

DEC 17 1941 19S. J. LEWIS Scout