


KANSAS Ellis County

Sec. 19 Twp. 11 R. 17W

Well No. #2 Peavey "D" Farm
Sunray Company


Bemis

Ft. from N. Line

660 Ft. from S. Line

Ft. from E. Line

330 Ft. from W. Line

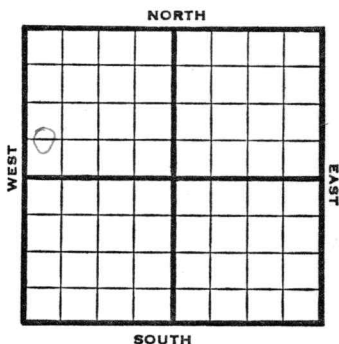

CWL SW NW

1946

Elev. 1863

REPORT

3/13

Location

3/21

13" - 120' Drlg. 960'

3/28

8" - 1110' Drlg. 3040'

4/4

Lans 3058
Cong. 3344
Simp 3351
Arb. 3356-3359
TD 3359
5" @ 3357' RUST

4/10

1500 acid; No help
TD 3388
Swb 1 oil PH

4/16

1000 acid no help
TD 3396,
Pump o oil PH

4/23

" " "

5/1

" " "

5/7

" " "

5/15

Arb. 3356
5" @ 3357
2000 acid.
TD 3393'
Pump 132 Pot.
Grav. 34.6

COMPLETED

KANSAS

Kansas

Pool Name BemisMap No. 71 Sec. 19 Twp. 11 R. 17WWell No. 2 Peavey "D"Sunray


Company

FIRST REPORT

Contractor

C W L SW NW

SECTION PLAT

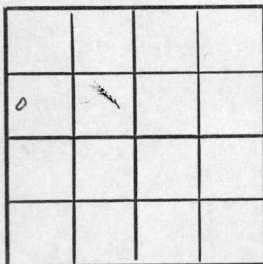Ft. from N. Line660 Ft. from S. LineFt. from E. Line330 Ft. from W. LineEllis CountyLocation X

Rig up

Drilling and Remarks:

RECORD

Cased in. ft.

Sand

Gas

Oil

Total Depth

PRODUCTION

1st 24 hrs. Nat. 1st 24 hrs. after shot Gas Cu. Ft.Dry Hole Abandoned

Date

MAR 13 1946

19

S. J. LEWIS

Scout

KANSAS Kansas Pool Name Bemis Pool
 Map No. 71 Sec. 19 Twp. 11 R. 17W
 Well No. 2 Peavey "D"

Sunray

Company

COMPLETED

Contractor

E. I. 1863

C W L SW NW

SECTION PLAT

0			

 Ft. from N. Line

660 Ft. from S. Line

 Ft. from E. Line

330 Ft. from W. Line

Ellis County

Location

Rig up

Drilling and Remarks:

Core 83356

5" @ 3357

2000 acid

Pump 182 Bt.

34 6 1/2

RECORD

Cased in. ft.

Sand

Gas

Oil

Total Depth 3328

PRODUCTION

1st 24 hrs. Nat.

1st 24 hrs. after shot

Gas Cu. Ft.

Dry Hole

Abandoned

Date

MAY 15 1946 19

S. J. LEWIS

Scout