


Section 3 Township 16 Range 11W

Well No. #1 Alden

Company Grant Oil

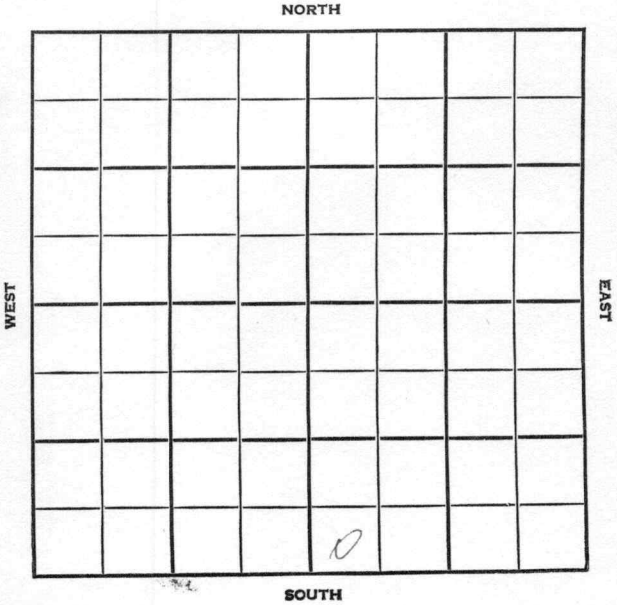

Barton

KANSAS

SEC.

TWP.

R.

3

16

11W

WELL NO.

#1 Alden

FARM

COMPANY

Grant Oil

CONTRACTOR

Walters

Semi-Wildcat


____ FT. FROM N. LINE

____ FT. FROM S. LINE

____ FT. FROM E. LINE

____ FT. FROM W. LINE

SW SW SE

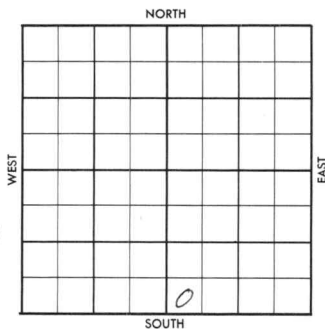

ELEVATION

REPORT

1956

8-15 MIR

County Barton Elev. 11W
 Sec. 3 Twp. 16 Rge. 11W
 Company Grant Oil
 Farm Name Alden No. 1

TOPS	DEPTH	LOG	DATUM	Loc. in Sec.
Anh.				SW SW SE
Tp.				
H.				
Tr.				
Dg.				
B.L.				
L.				Geol.
K.C.				Contr.
B.K.C.				Walters
Ce.				Pool
C.				Semi-Wildcat
M.				
M.				
K.				
Mz.				
Me.				
V.				
S.				
S.				
A.				
R.				
Pe.				
G.				
T.D.				

Date Comm.

M I R

AUG 15 '56

AUG 5 1956

R. G.

County Barton Elev. 1867
 Sec. 3 Twp. 16 Rge. 11W
 Company Grant Oil
 Farm Name Alden No. 1

TOPS	DEPTH	LOG	DATUM
------	-------	-----	-------

Anh.	704		
TP.	2602		
H.	2898		
Tr.	2916		
Dg.			
Bl.	2989		
L.	3006		
K.C.			
B.K.C.			
Ce.			
C.			
M.			
M.			
K.			
Mz.			
Mq.			
V.			
S.			
S.			
A	3323		
R.			
P.E.			
G.			
T.D.	3336		

Loc. in Sec. _____

SW SW SE

Geol. _____

Contr. _____

Walters

Pool _____

Semi-Wildcat

ABANDONED
 SEP 19 '56
 0

Date Comm.

M I R AUG 22 '56 8-16-56 85/8

319/185 Ø 2107 AUG 29 '56 Pipe

set Tite 2 DST SEP 5 '56 Tite

5 1/2" @ 3326 SEP 12 '56 DST 3035-47

1 hr. run 360' G.I.P. run 26' Md

BHP 80 Pipe run SEP 19 '56 co

3336 12 1/2" Hole Full w/

D & A