


Section 36 Township 13 Range 15WWell No. #1-A BoxbergerCompany Icer Addis & M. Miller

NORTH

WEST

EAST

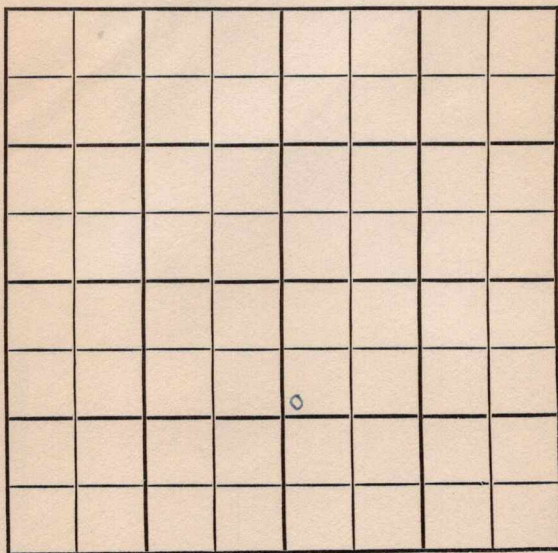

SOUTH

Russell

KANSAS

SEC.	TWP.	R.
36	13	15W

WELL NO.

1-A Boxberger

FARM

COMPANY

Icer Addis & M. Miller

CONTRACTOR

Mast Drlg.

Gorham

_____ Ft. from N. Line

1550'


_____ Ft. from S. Line

_____ Ft. from E. Line

350'

_____ Ft. from W. Line

SW NW SE

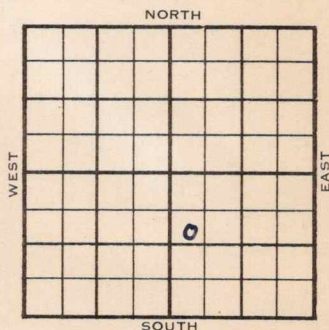

1955	ELEVATION	REPORT
------	-----------	--------

6/15

Comm 6-11-55

8" @ 200/125

Drlg 1370

7/7

DST 3298-3300 open 1 hr. Rec 110' socm 975/20" DST 3301-08 open 1 hr. Rec. 30' ocm 63' wcm 925/20" DST 3307-10 open 1 hr. Rec 18' ocm 55 wcm 975/20" TD 3325 B&A.

Tops:	Depth	Datum
Tp.	2755	883
K.C.	3033	1161
C.Gorham	3298-	1426
TD:	3310	

ABANDONED

County Russell ✓ Elev. _____ Co.
 Sec. 36 Twp. 13 Rge. 15W
 Company Icer Addis & M. Miller
 Farm Name Boxberger No. 1-A

TOPS	DEPTH	LOG	DATUM	Loc. in Sec.
Anh.				SW NW SE
Tp.				1550' SL
H.				350' WL
Tr.				Geol.
Dg.				Contr.
Bl.				Mast Drlg.
L.				Pool
K.C.				Gorham
B.K.C.				FIRST REPORT JUN 15 '55
Cc.				
C.				
M.				
M.				
K.				
Mz.				
Mq.				
V.				
S.				
S.				
A.				
R.				
Pe.				
G.				
T.D.				

Date Comm. 6-11-55

8" @ 200/125 drlg. 1370

Co.

Lse.

No.

Sec.

T.

R.

County Russell Elev. 1872
 Sec. 36 Twp. 13 Rge. 15W
 Company Icer Addis & M. Miller
 Farm Name Boxberger No. 1-A

TOPS

DEPTH

LOG

DATUM

Loc. in Sec.

Anh.				SW NW SE
Tp.	2755		883	
H.				1550' SL
Tr.				350' WL
Dg.				
Bl.				
L.				Geol.
K.C.	3033		1161	Contr.
B.K.C.				
Ce.				Mast D _r lg.
C. Gorham	3298		1426	
M.				Pool
M.				Gorham
K.				
Mz.				
Me.				
V.				
S.				
S.				
A.				
R.				
PE.				
G.				
TD.	3340			



Date Comm. 6-11-55 JUL 6 1955
8" @ 200/125 DST 3298-3300 open 1 hr.
Rec. 110' socm 975/20" DST 3301-08
open 1 hr. Rec. 30' ocm 63' wcm
925/20" DST 3307-10 open 1 hr.
Rec. 18' ocm 55' wcm 975/20" TD 3325

D & A