


*Lyon.*

Map No. *1* Sec. *21* Twp. *18* R. *13*

Well No. *1 - Fuller* Farm

*Watchorn O. G.* Company

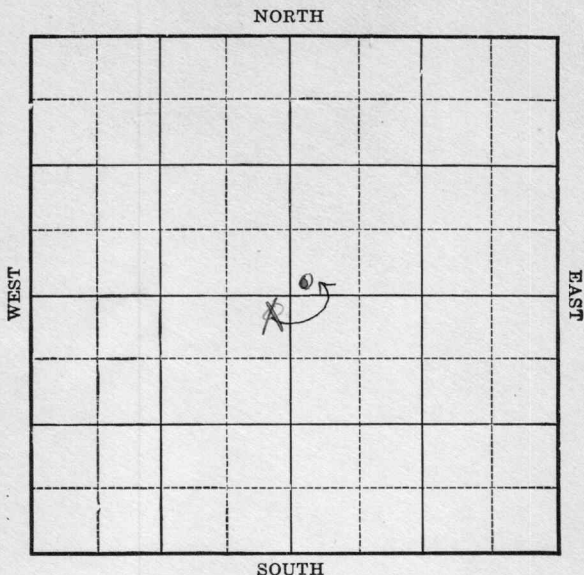

Location \_\_\_\_\_

Drilling Remarks

Rig Up \_\_\_\_\_

Drilling Remarks

**RECORD**

Cased \_\_\_\_\_ in. \_\_\_\_\_ ft.

Sand \_\_\_\_\_

Gas \_\_\_\_\_

Oil \_\_\_\_\_

Total Depth \_\_\_\_\_

**PRODUCTION**


1st 24 hrs. Nat. \_\_\_\_\_

1st 24 hrs. after shot \_\_\_\_\_

Gas \_\_\_\_\_ cu. ft.

Dry Hole \_\_\_\_\_

Abandoned \_\_\_\_\_

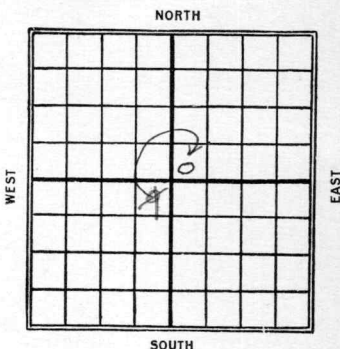Map No. Kansas Sec. 21 Twp. 18 R. 13Well No. 1- Fuller FarmWatchorn Oil Company~~330~~ Ft. from N. Line330 Ft. from S. Line~~330~~ Ft. from E. Line330 Ft. from W. Line1926.

Date

REPORT

|      |                           |
|------|---------------------------|
| 4/21 | Location                  |
| 4/28 | Log                       |
| 5/8  | Rigs                      |
| 5/14 | Slg 325' Change location. |
| 5/19 | " 970                     |
| 6/2  | drlg 1930' mixed sand.    |
| 6/10 | " 2000'                   |
| 6/18 | " 2330                    |
| 6/24 | S. & A. 2500              |

Map No. *21* **KANSAS** Sec. *18* Twp. *13* R. *13*

Well No. *1* *Zulber*  
*Watchorn Oil Co.* Company

Contractor

## FIRST REPORTS

## SECTION PLAT

*330* Ft. from N. Line

Ft. from S. Line

*330* Ft. from E. Line

Ft. from W. Line

|  |   |  |  |
|--|---|--|--|
|  |   |  |  |
|  |   |  |  |
|  | o |  |  |
|  |   |  |  |

Location ☒

Rig up

Drilling and Remarks:

## RECORD

Cased \_\_\_\_\_ in., \_\_\_\_\_ ft.

Sand \_\_\_\_\_

Gas \_\_\_\_\_

Oil \_\_\_\_\_

Total Depth \_\_\_\_\_

## PRODUCTION

1st 24 hrs. Nat. \_\_\_\_\_

1st 24 hrs. after shot \_\_\_\_\_

Gas \_\_\_\_\_ Cu. Ft.

Dry Hole \_\_\_\_\_

Abandoned \_\_\_\_\_

Date

APR 21 1926

CHAS. L. SHERWOOD

192


Scout

Map No. *KANSAS* Sec. *21* Twp. *18* R. *13*

Well No. *1* *Fulton*  
*Notchory Oil Co.* Company

Contractor

## SECTION PLAT

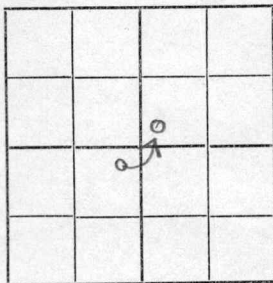

Ft. from N. Line

*330*

Ft. from S. Line

Ft. from E. Line

*330*

Ft. from W. Line

## CORRECTION

Location

Rig up

Drilling and Remarks:

*ok 325*

*chg location*

## RECORD

Cased \_\_\_\_\_ in., \_\_\_\_\_ ft.

Sand \_\_\_\_\_

Gas \_\_\_\_\_

Oil \_\_\_\_\_

Total Depth \_\_\_\_\_

## PRODUCTION

1st 24 hrs. Nat. \_\_\_\_\_

1st 24 hrs. after shot \_\_\_\_\_

Gas \_\_\_\_\_ Cu. Ft.

Dry Hole \_\_\_\_\_

Abandoned \_\_\_\_\_

Date

MAY 12 1926

192

CHAS. L. SHERWOOD

Scout

KANSAS

Map No. \_\_\_\_\_ Sec. 21 Twp. 18 R. 13Well No. 1 Fullock  
Watchorn Oil & Co. Company

Contractor

## COMPLETED

## SECTION PLAT

Ft. from N. Line

330 Ft. from S. Line

Ft. from E. Line

330 Ft. from W. Line

## ABANDONED

|  |  |  |  |
|--|--|--|--|
|  |  |  |  |
|  |  |  |  |
|  |  |  |  |
|  |  |  |  |
|  |  |  |  |

Location \_\_\_\_\_

Rig up \_\_\_\_\_

Drilling and Remarks:

Top line 1950  
Wilcox 2493-2500  
DFH.  
Oil 2500

## RECORD

Cased \_\_\_\_\_ in., \_\_\_\_\_ ft.

Sand \_\_\_\_\_

Gas \_\_\_\_\_

Oil \_\_\_\_\_

Total Depth 2500

## PRODUCTION

1st 24 hrs. Nat. \_\_\_\_\_

1st 24 hrs. after shot \_\_\_\_\_

Gas \_\_\_\_\_ Cu. Ft.

Dry Hole ☒Abandoned ☒

Date

JUN 24 1926

CHAS. L. SHERWOOD

192

Scout