


KANSAS

Section 22 Township 8 Range 19 W

Well No. #3 Green "D"

Company Northern Ordiance

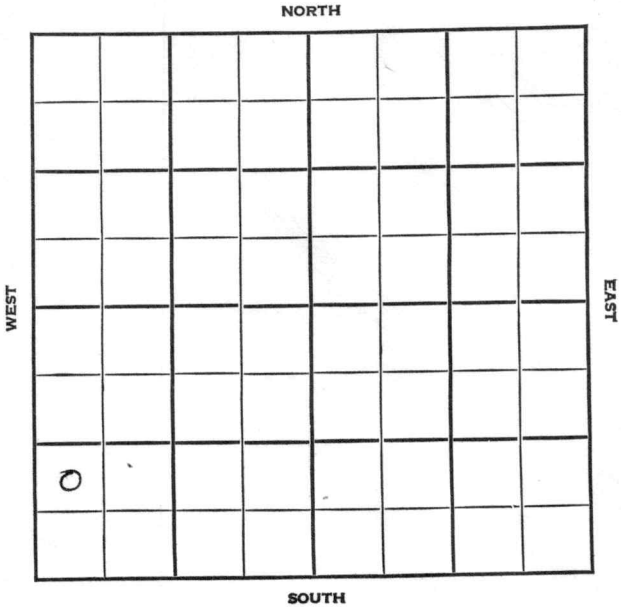

Rooks

Sec. 22 **KANSAS** Twp. 8 R. 19W

Well No. #3 Green "D" Farm

Northern Ordinance

Company

Webster Pool

Ft. from N. Line

990'
330'

Ft. from S. Line


Ft. from E. Line

330'
990'

Ft. from W. Line

NW

SE SW SW

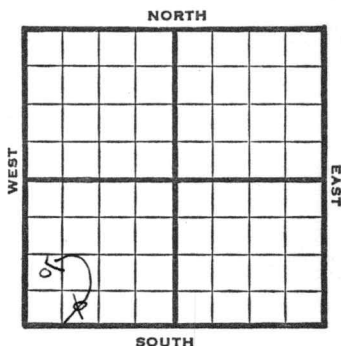

1948

Eli 1976'

REPORT

6/16

Location

6/23

8" @ 229

Drlg 2735'

6/29

Topeka 2931'

Lansing 3163'

Arbuckle 3407'

TD 3408'

5" @ 3408'

RUST

7/8

"

7/14

"

7/21

"

7/28

"

8/4

"

8/11

TD 3415'

700' oil

8/18

TD 3415'

8/25

"

9/1

Arb. 3407'

5" @ 3408'

TD 3415'

Pump 78 oil Pot

28° Gr.

Comp

COMPLETED

Map No. _____ Sec. 22 Twp. 8 R. 19W

Well No. 3 Green "D"

Northern Ordinance Company

FIRST REPORT

Contractor

SE SW SW


SECTION PLAT

_____ Ft. from N. Line

330 Ft. from S. Line

_____ Ft. from E. Line

990 Ft. from W. Line

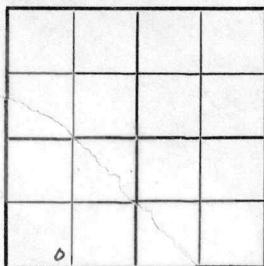

Rooks County

Location X

Rig up _____

Drilling and Remarks:

RECORD

Cased _____ in., _____ ft.

Sand _____

Gas _____

Oil _____

Total Depth _____

PRODUCTION

1st 24 hrs. Nat. _____

1st 24 hrs. after shot _____

Gas _____ Cu. Ft.

Dry Hole _____

Abandoned _____

Date

JUN 16 1948 19 S. J. LEWIS Scout

200 Bks. 1-48—Palace
Kansas

Map No. 65 Sec. 22 Twp. 8 R. 19W

Well No. 3 Green "D"

Northern Ordinance Company

CORRECTION

Contractor

NW SW SW

SECTION PLAT

o			

Ft. from N. Line

990 Ft. from S. Line

Ft. from E. Line

330 Ft. from W. Line

Rooks County

Location

Rig up

Drilling and Remarks:

Reported

SE SW SW

RECORD

Cased _____ in., _____ ft.

Sand _____

Gas _____

Oil _____

Total Depth _____

PRODUCTION

1st 24 hrs. Nat. _____

1st 24 hrs. after shot _____

Gas _____ Cu. Ft.

Dry Hole _____

Abandoned _____

Date

JUN 23 1948 19 S. J. LEWIS Scout

Rooks County Kansas State

Map No. 65 Sec. 22 Twp. 8 R. 19W

Well No. 3 Green "D"

Northern Ordinance Company


COMPLETE

Contractor

NW SW SW

E. 1976

SECTION PLAT

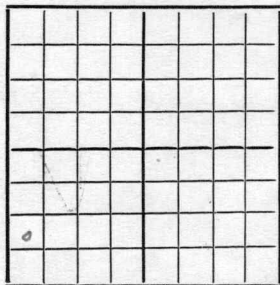

 Ft. from N. Line

990 Ft. from S. Line

 Ft. from E. Line

990 Ft. from W. Line

Webster Pool

Remarks:

CU 83407

5" @ 3408

Y 8413

Pump. 7 Tail Port

280 Gr.

Date

SEP 1 1948

Scout

S. J. LEWIS