

KANSAS


Greenwood



Section 20 Township 27 Range 11E

Well No. #1 Forbes

Company K T Weidemann

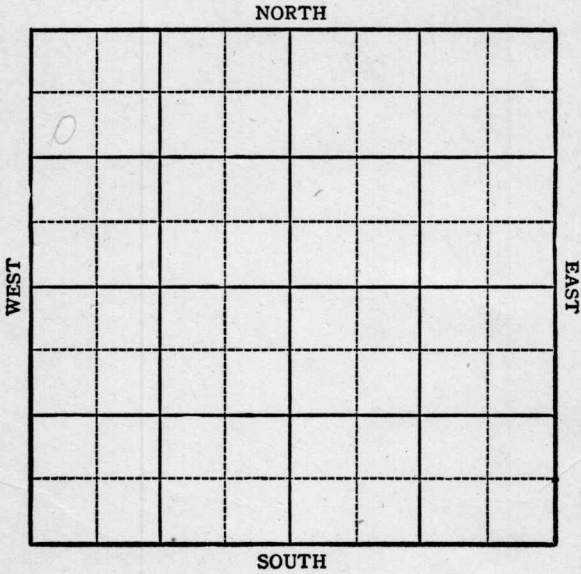

Sec. 20 Twp. 27 R. 11E

Well No. #1 Forbes Farm

K. T. Weidemann Company


Misc.

990 Ft. from N. Line

_____ Ft. from S. Line

_____ Ft. from E. Line

330 Ft. from W. Line

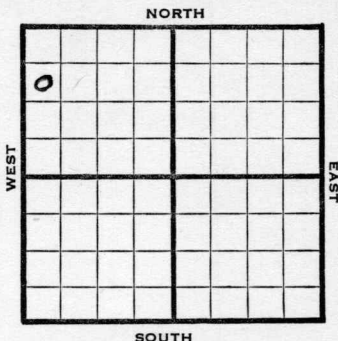

SW NW NW

REPORT

1944

8/16	Loc.	
8/23	"	
8/30	Apud	
9/8	Drlg. 190	
9/13	12 $\frac{1}{2}$ " @ 555	Drlg. 900'
9/21	10" @ 1335	Drlg. 1410
9/28	8" @ 2009	
	Miss 2038	
	Drlg. 2050	SO
10/4	Drlg. 2200	
10/11	7" @ 2410	SO 2419 TD
	Arb 2417	tstg.
10/18	TD 2431	110 acid 1500 wtr 1/3 hr.
10/25	Arb 2417	
	TD 2452	

ABANDONED

KANSAS

Pool Name Miscellaneous

Map No. 9 Sec. 20 Twp. 27 R. 11E

Well No. 1 Forbes

K. T. Weidemann Company

FIRST REPORT Contractor

SW NW NW

SECTION PLAT

990 Ft. from N. Line

_____ Ft. from S. Line

_____ Ft. from E. Line

330 Ft. from W. Line

o			

Greenwood County

Location X

Rig up _____

Drilling and Remarks:

RECORD

Cased _____ in., _____ ft.

Sand _____

Gas _____

Oil _____

Total Depth _____

PRODUCTION

1st 24 hrs. Nat. _____

1st 24 hrs. after shot _____

Gas _____ Cu. Ft.

Dry Hole _____

Abandoned _____

Date

AUG 16 1944

19

S. J. LEWIS

Scout

KANSAS

Pool Name Miscellaneous

Map No. 9 Sec. 20 Twp. 27 R. 11E

Well No. 1 Forbes

K. T. Weidemann Company

ABANDONED

Contractor

SW NW NW

SECTION PLAT

990 Ft. from N. Line

_____ Ft. from S. Line

_____ Ft. from E. Line

330 Ft. from W. Line

4			

Greenwood County

RECORD

Location _____

Cased _____ in., _____ ft.

Rig up _____

Sand _____

Drilling and Remarks:

Gas _____

Cur 2417

Oil _____

Total Depth 2452

PRODUCTION

1st 24 hrs. Nat. _____

1st 24 hrs. after shot _____

Gas _____ Cu. Ft.

Dry Hole _____

Abandoned _____

Date

OCT 25 1944

19

S. J. LEWIS Scout