

KANSAS

Form 51—5M—7-40—Palace

Greenwood



Section 27 Township 27 Range 11-E

Well No. #1 Hillard

Company Brazil et al

NORTH

Miscellaneous

WEST

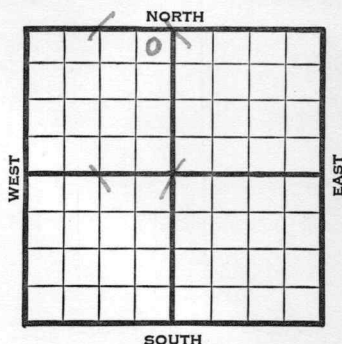
EAST

			0				

SOUTH

Sec. 27 Twp. 27 R. 11-EWell No. #1 Hillard FarmBrazil et al Company

(Misc.)

330 Ft. from N. Line Ft. from S. Line330 Ft. from E. Line Ft. from W. Line

1941	REPORT
3/26	Location
4/3	"
4/10	Machine.
4/18	"
4/24	Spud.
5/1	Shut down.
5/8	" "
5/15	7" - 1812' Drlg. 1824'
5/22	Spud & SD.
5/28	" "
6/5	" "
6/12	" "
6/19	" "
6/26	" "
7/3	" "
7/10	" "
7/17	" "
7/24	" "
7/30	TD 10'
	Spud
	ABANDONED

Map No. 9 Sec. 27 Twp. 27 R. 11EWell No. 1 HillardBrazil etal

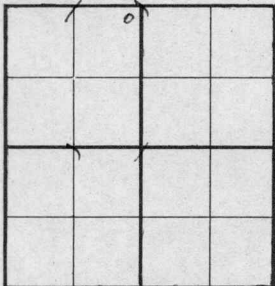
Company

FIRST REPORT

Contractor

NE NW

SECTION PLAT

330 Ft. from N. Line

Ft. from S. Line

330 Ft. from E. Line

Ft. from W. Line

MISCELLANEOUS

Location XRig up 11

Drilling and Remarks:

RECORD

Cased _____ in., _____ ft.

Sand _____

Gas _____

Oil _____

Total Depth _____

PRODUCTION

1st 24 hrs. Nat. _____

1st 24 hrs. after shot _____

Gas _____ Cu. Ft.

Dry Hole _____

Abandoned _____

Date

MAR 26 1941 19S. J. LEWIS Scout

KANSAS

Map No. 9 Sec. 27 Twp. 27 R. 11EWell No. 1 HillardBrazil et al CompanyABANDONED Contractor

NE NW

SECTION PLAT

330 Ft. from N. Line Ft. from S. Line330 Ft. from E. Line Ft. from W. Line

MISCELLANEOUS

Location Rig up

Drilling and Remarks:

Spud

RECORD

Cased in., ft.Sand Gas Oil Total Depth 40'

PRODUCTION

1st 24 hrs. Nat. 1st 24 hrs. after shot Gas Cu. Ft.Dry Hole Abandoned

Date

JUL 30 1941

19

S. J. LEWIS

Scout