


KANSAS Greenwood County

FORM 51 5M PETROL

Section 18 Township 27 Range 11E

Well No. 3 Peterson

Company K. T. Weidemann

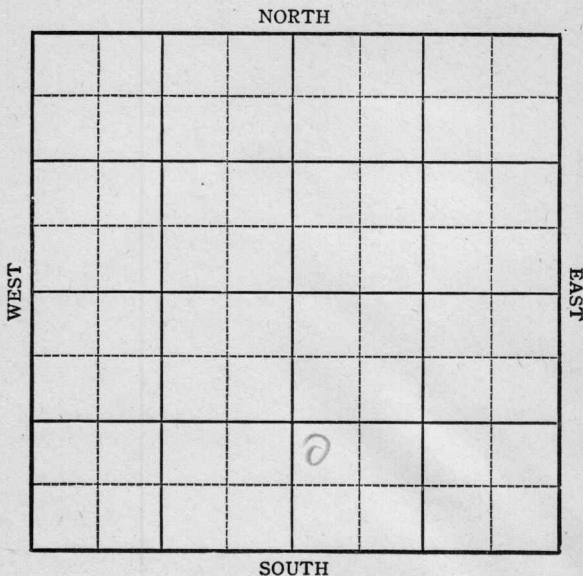

Sec. 18 Twp. 27 R. 11E

Well No. 3 Peterson Farm

K. T. Weidemann Company


Miscellaneous

\_\_\_\_\_ Ft. from N. Line

990 Ft. from S. Line

\_\_\_\_\_ Ft. from E. Line

330 Ft. from W. Line

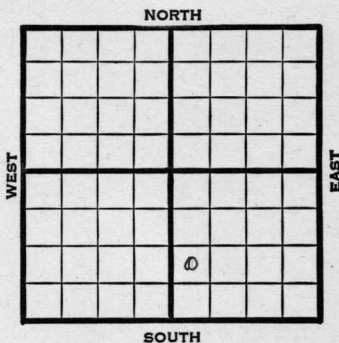

NW SW SE

1945

REPORT

6/13

12" -605

10" -952

1025

7/3

Miss. 1959

7" @ 1957

TD 1990'

ABANDONED

Kansas Pool Name Miscellaneous

Map No. 9 Sec. 18 Twp. 27 R. 11E

Well No. 3 Peterson

K. T. Weidemann Company

FIRST REPORT Contractor

NW SW SE

SECTION PLAT

		o	

\_\_\_\_\_ Ft. from N. Line

990 Ft. from S. Line

\_\_\_\_\_ Ft. from E. Line

330 Ft. from W. Line

Greenwood County

Location \_\_\_\_\_

Rig up \_\_\_\_\_

Drilling and Remarks:

12"-605  
10"-952  
1025

RECORD

Cased \_\_\_\_\_ in., \_\_\_\_\_ ft.

Sand \_\_\_\_\_

Gas \_\_\_\_\_

Oil \_\_\_\_\_

Total Depth \_\_\_\_\_

PRODUCTION

1st 24 hrs. Nat. \_\_\_\_\_

1st 24 hrs. after shot \_\_\_\_\_

Gas \_\_\_\_\_ Cu. Ft.

Dry Hole \_\_\_\_\_

Abandoned \_\_\_\_\_

Date

JUN 13 1945 19

S. J. LEWIS Scout

