


Map No. KANSAS Sec. 20 Twp. 27 R. 11^E
Well No. 1 Peterson Farm
Elk River Oil Company

NORTH

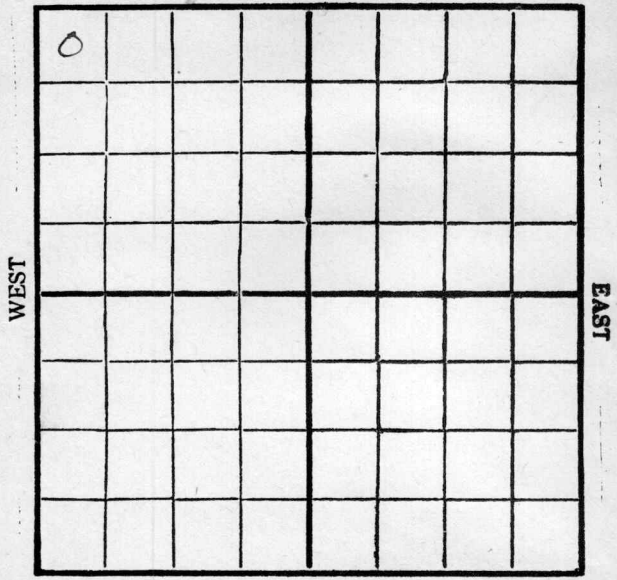

SOUTH

Location _____
Drilling Remarks _____

Rig Up _____
Drilling Remarks _____

RECORD

Cased _____ in. _____ ft.
Sand _____
Gas _____
Oil _____
Total Depth _____

PRODUCTION

1st 24 hrs. Nat. _____
1st 24 hrs. after shot _____
Gas _____ cu. ft. _____
Dry Hole _____
Abandoned _____


Map No. KANSAS Sec. 20 Twp. 27 R. 11^E
Well No. Peterson Farm
Elk River Oil Company

300 Ft. from N. Line

_____ Ft. from S. Line

_____ Ft. from E. Line

300 Ft. from W. Line

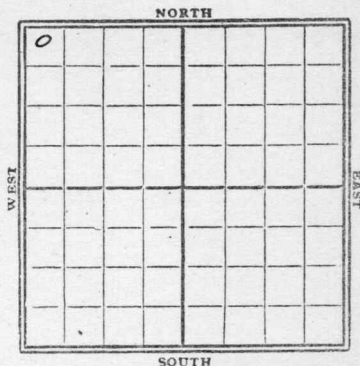

1929

Date REPORT

Date	REPORT
7/31	Machine
8/7	Sp dy.
8/14	Shut down
8/21	—
8/28	—
9/14	Drly 540'
9/11	" 1200'
9/18	S.D. 1246'
9/25	—
10/2	—
10/9	—
10/16	Drly 1800'
10/23	Top line 1984-2014 S.D. 2014' HFW
10/30	—
11/6	Top line 1984' HFW 2014' TD. Dry & Abandoned

Greenwood
 K 9 **KANSAS** Sec. *20* Twp. *27* R. *11* ^E
 Map No. _____
 Well No. *1* *Peterson*
Elk River Oil Co Company
 Contractor _____

FIRST REPORTS

300 Ft. from N. Line

_____ Ft. from S. Line

_____ Ft. from E. Line

300 Ft. from W. Line

SECTION PLAT

0			

Location _____

Rig up _____

Drilling and Remarks:

RECORD

Cased _____ in., _____ ft.

Sand _____

Gas _____

Oil _____

Total Depth _____

PRODUCTION

1st 24 hrs. Nat. _____

1st 24 hrs. after shot _____

Gas _____ Cu. Ft.

Dry Hole _____

Abandoned _____

Date

JUL 3 1 1929

CHAS. L. SHERWOOD

19

Scout

9 *Greenwood*
 Map No. **KANSAS** Sec. *20* Twp. *27* R. *11*

Well No. *1 Peterson*
Elk River W. Co. Company

Contractor

SECTION PLAT

0			

300 **COMPLETE**
 Ft. from N. Line

Ft. from S. Line

Ft. from E. Line

300 Ft. from W. Line

ABANDONED

Location

Rig up

Drilling and Remarks:

Top line 1984
HW 2014

RECORD

Cased in., ft.

Sand

Gas

Oil

Total Depth *2014*

PRODUCTION

1st 24 hrs. Nat.

1st 24 hrs. after shot

Gas Cu. Ft.

Dry Hole ☒

Abandoned ☒

Date

NOV 6 1929

CHAS. L. SHERWOOD

192 Scout