

KANSAS


Greenwood




Section 27 Township 27 Range 11-E

Well No. #1 Hillard

Company Winkleman & Abells
(Wildcat)

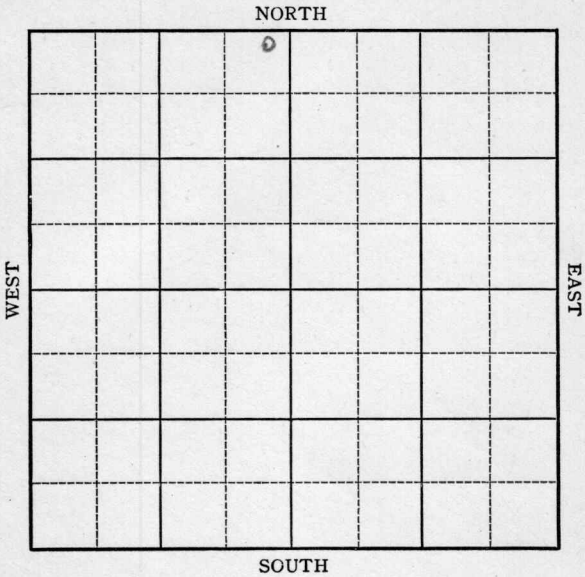

_____Ft. from W. Line

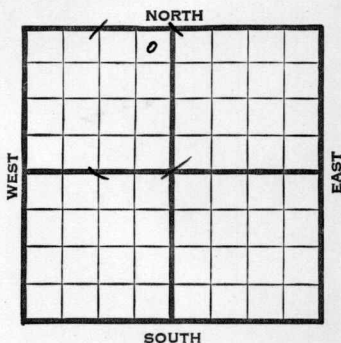[illegible]

KANSAS

Map No. 7 Sec. 27 Twp. 27 R. 11EWell No. 1 Hillard

Winkleman & Abels

Company

FIRST REPORT

Contractor


SECTION PLAT

440 NE NW
Ft. from N. Line

Ft. from S. Line

440 Ft. from E. Line

Ft. from W. Line

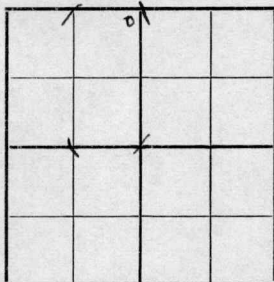

WILDCAT

Location _____

Rig up _____

Drilling and Remarks:
Machine

RECORD

Cased _____ in., _____ ft.

Sand _____

Gas _____

Oil _____

Total Depth _____

PRODUCTION

1st 24 hrs. Nat. _____

1st 24 hrs. after shot _____

Gas _____ Cu. Ft.

Dry Hole _____

Abandoned _____

Date

AUG 6

1941

19

S. J. LEWIS

Scout

Map No. 9 Sec. 27 Twp. 27 R. 11EWell No. 1 HillardWickleman & Abels CompanyABANDONED Contractor

SECTION PLAT

NE NW

440 Ft. from N. Line Ft. from S. Line440 Ft. from E. Line Ft. from W. Line

WILDCAT

RECORD

Location Rig up

Drilling and Remarks:

Cased in., ft.Sand Gas Oil Total Depth 1300

PRODUCTION

1st 24 hrs. Nat. 1st 24 hrs. after shot Gas Cu. Ft.Dry Hole Abandoned

Date

SEP 10 1941 19S. I. LEWIS Scout