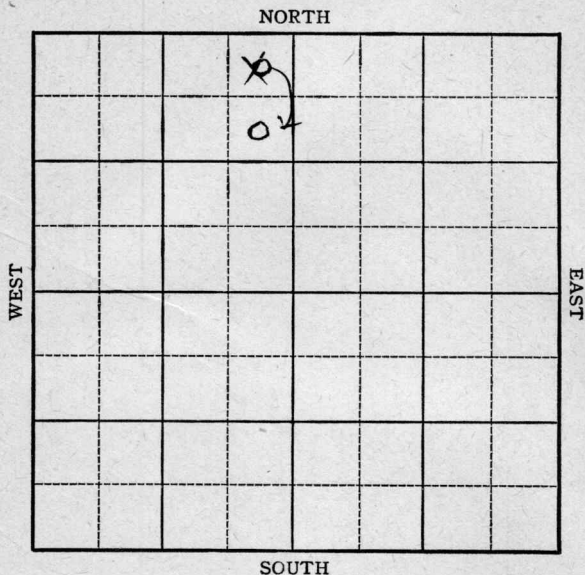


Section 29 Township 27 Range 11-EWell No. #1 BlenchaCompany Barber Oil

KANSAS

Greenwood County

Sec. 29 Twp. 27 R. 11E

Well No. #1 Blencha Farm

Barber Oil Company


Miscellaneous

~~330~~ 990 Ft. from N. Line

_____ Ft. from S. Line

330 Ft. from E. Line

_____ Ft. from W. Line

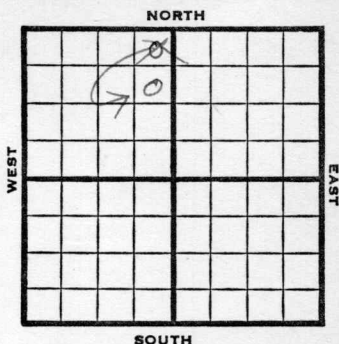

~~NE NW~~ SE NE NW

1946	REPORT
2/13 2/21 2/28 3/7 3/14	Location " " " " " " " "
3/21 3/28 4/4	Machine. 15" - 20' Drlg. 245' 12" @ 375 10" @ 660 Drlg. 670
4/10 4/16	Drlg 890 KC 1164, 8" @ 1180 Uswego 1634 Drlg 1873
4/23	Miss 1968-6" @ 1970 Drlg 2030
5/1	Drlg 2280'
5/8	Arb. 2343 TD 2346'

ABANDONED

KANSAS

Kansas Pool Name MiscellaneousMap No. 9 Sec. 29 Twp. 27 R. 11EWell No. 1 BlenchaBarber Oil


Company

CORRECTION+ 1st

Contractor

NE NW

SECTION PLAT

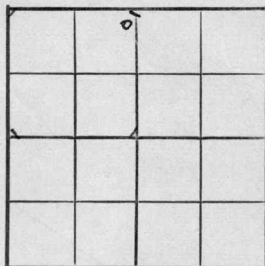330 Ft. from N. Line Ft. from S. Line330 Ft. from E. Line Ft. from W. Line

Greenwood County

Location Rig up
 Drilling and Remarks:
had spotted in
SE NW

RECORD

Cased in., ft.Sand Gas Oil Total Depth

PRODUCTION

1st 24 hrs. Nat. 1st 24 hrs. after shot Gas Cu. Ft.Dry Hole Abandoned

Date

FEB 13 1946 19S. J. LEWIS Scout

KANSAS

Kansas Pool Name MiscellaneousMap No. 9 Sec. 29 Twp. 27 R. 11EWell No. 1 BlenchaBarbara Oil

Company

CORRECTION

Contractor

SE NE NW


SECTION PLAT

990 Ft. from N. Line

Ft. from S. Line

330 Ft. from E. Line

Ft. from W. Line

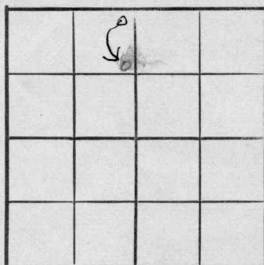Greenwood County

Location

Rig up

Drilling and Remarks:

Reported NE NW

RECORD

Cased _____ in., _____ ft.

Sand _____

Gas _____

Oil _____

Total Depth _____

PRODUCTION

1st 24 hrs. Nat. _____

1st 24 hrs. after shot _____

Gas _____ Cu. Ft.

Dry Hole _____

Abandoned _____

Date

FEB 20 1946

19

S. J. LEWIS

Scout

KANSAS Kansas Pool Name MiscellaneousMap No. 9 Sec. 29 Twp. 27 R. 11EWell No. 2 BlenchaBarbara Oil

Company

ABANDONED

Contractor

SE NE NW

SECTION PLAT

990 Ft. from N. Line

Ft. from S. Line

330 Ft. from E. Line

Ft. from W. Line

Greenwood County

Location

Rig up

Drilling and Remarks:

CR 2343

RECORD

Cased _____ in., _____ ft.

Sand _____

Gas _____

Oil _____

Total Depth 2546

PRODUCTION

1st 24 hrs. Nat. _____

1st 24 hrs. after shot _____

Gas _____ Cu. Ft.

Dry Hole _____

Abandoned _____

Date

MAY 8 1946 19S. J. LEWIS Scout