

KANSAS

Form 51-5M-7-40-Palace

Greenwood




Section 32 Township 27 Range 11-E

Well No. #1 Stonebreaker


Company E. W. Creel et al

Climas Pool

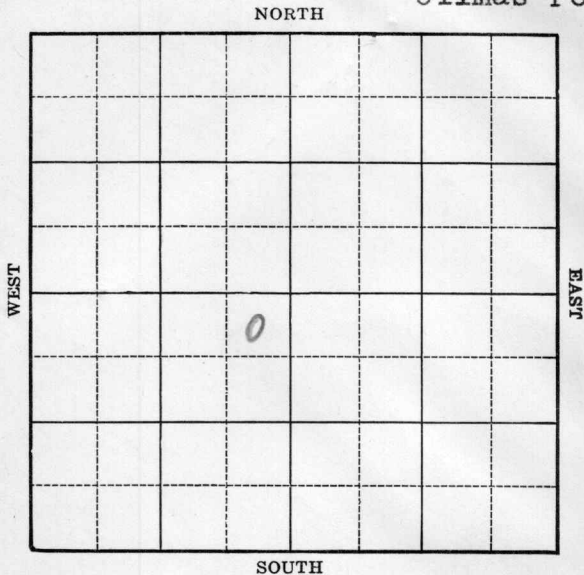

Sec. 32 Twp. 27 R. 11-EWell No. #1 Stonebreaker FarmE. W. Creel et al Company

(Climas)

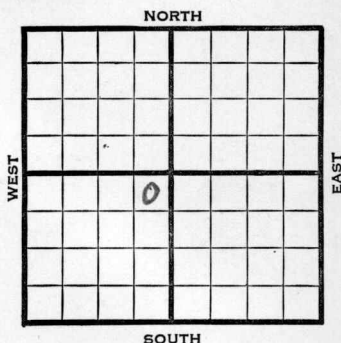330 Ft. from N. Line Ft. from S. Line330 Ft. from E. Line Ft. from W. Line

1940

REPORT

10/2 Machine.

10/10 Spud.

10/17 Drlg. 345'

10/24 8" - 300' 6" - 600' C.O.

10/31 Shut down.

11/7 Drlg. 1160'

11/14 5" - 1194'

SD 1254'

11/21 No report.

11/26 T.D. 1305'

H.F.W. 1305'

ABANDONED

Map No. 9 Sec. 32 Twp. 27 R. 11EWell No. 1 StonebreakerE. W. Creel etal Company

Contractor

FIRST REPORT

SECTION PLAT

330 NE SW
Ft. from N. Line

Ft. from S. Line

330 Ft. from E. Line

Ft. from W. Line

Climas Pool

	o		

Location _____

Rig up _____

Drilling and Remarks:

Machine

RECORD

Cased _____ in., _____ ft.

Sand _____

Gas _____

Oil _____

Total Depth _____

PRODUCTION

1st 24 hrs. Nat. _____

1st 24 hrs. after shot _____

Gas _____ Cu. Ft.

Dry Hole _____

Abandoned _____

Date

OCT 2 1940S. J. LEWIS Scout

Map No. 9 Sec. 32 Twp. 27 R. 11EWell No. 1 StonebreakerE. W. Creel et al

Company

Contractor

ABANDONED

NE SW

330 Ft. from N. Line Ft. from S. Line330 Ft. from E. Line Ft. from W. Line

CLIMAS POOL

SECTION PLAT

	o		

Location Rig up

Drilling and Remarks:

1305 NFW:

RECORD

Cased in., ft.Sand Gas Oil Total Depth 1305

PRODUCTION

1st 24 hrs. Nat. 1st 24 hrs. after shot Gas Cu. Ft.Dry Hole Abandoned

Date

NOV 26 1940 19S. J. LEWIS Scout