


Section 32 Township 27 Range 11E

Well No. #2 Gavret

Company Hudson & McGuire

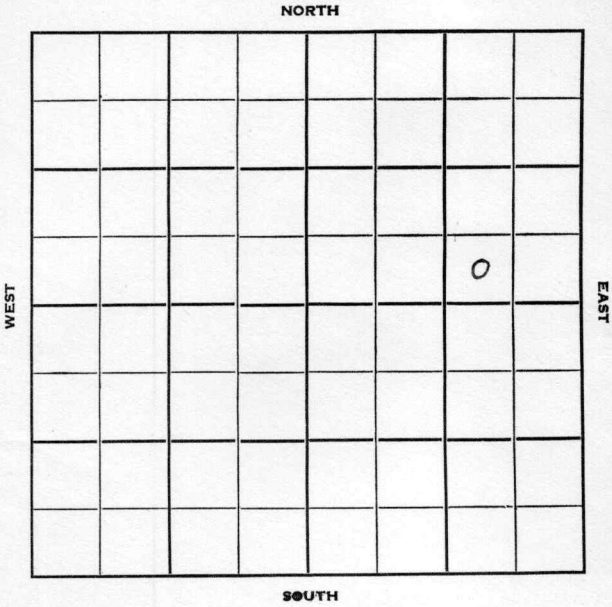

Greenwood **KANSAS** ✓

Sec. 32 Twp. 27 R. 11E

Well No. #2 Gavret Farm _____

Hudson & McGuire Company _____

Feaster - Contr. Contractor _____


_____ Ft. from N. Line

330' Ft. from S. Line

990' Ft. from E. Line

_____ Ft. from W. Line

SW SE NE

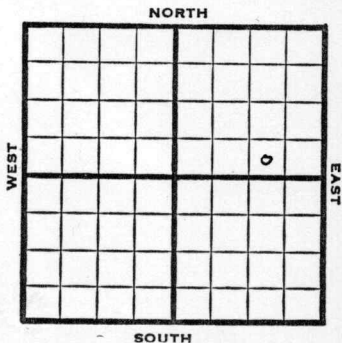

1950

?

REPORT

12/6

Spud 11-30-50
Drlg. 365'

1951
1/10

Spud 11-30-50

8" @ 608

KC 1290

Miss 1955

5" @ 1959

TD 1960

Comp 10 bopd

Completed

COMPLETED

County Greenwood State KansasSec. 32 (Blk. Twp.) 27 (Sur. Rge.) 11E Map No.Operator Hudson & McGuireWell No. 2 Farm GavretElev. _____ Location SW SE NE

330 Ft. From S Line NE990 Ft. From E Line Quarter1st. Report DEC 6 1950

Completion _____

Remarks _____

Feaster - Contr.Spudding Date 11-30-50

Drlg. Data _____

drlg. 365

J. E. TYRA

