

Map No. Kansas Sec. 3 Twp. 27 R. 12


Well No. 1 W. H. Freeman Farm
Cosden Oil & Gas Company

250 Ft. from N. Line

..... Ft. from S. Line

..... Ft. from E. Line

250 Ft. from W. Line

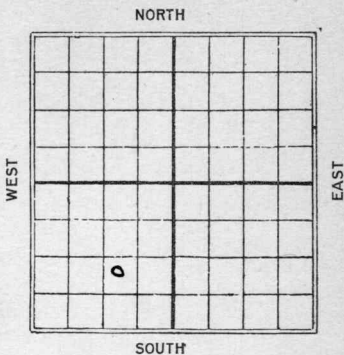

Date REPORT

1925

5/10 Location

7/21 1282

7/24 fish 10" - bit 15 30'

7/31

8/4 8" 1801 1/2 lg 1870 (2el)

8/7 Top L. 1800 set 8" 1801
 1/2 lg. 1870'

8/14 2060

8/20 2200'

8/27 2280'

9/3 2400

9/11 Abandoned 2482

Map No. Sands Sec. 3 Twp. 27 R. 12

Well No. 1
Corden Oil & Gas Co Company

Contractor

FIRST REPORTS

SECTION PLAT

250 Ft. from N. Line
 _____ Ft. from S. Line
 _____ Ft. from E. Line
250 Ft. from W. Line

	0		

Location _____

Rig up _____

Drilling and Remarks:

*Fishing 10" bit
 at 1530'*

RECORD

Cased _____ in., _____ ft.
 Sand _____
 Gas _____
 Oil _____
 Total Depth _____

PRODUCTION

1st 24 hrs. Nat. _____
 1st 24 hrs. after shot _____
 Gas _____ Cu. Ft.
 Dry Hole _____
 Abandoned _____

Date

JUL 24 1925

CHAS. L. SHERWOOD

Scout

Sherwood Co

Map No. 9 KANSAS Sec. 3 Twp. 27 R. 12

Well No. 1 *W. H. Ziehm*
Cadden Oil & Gas Co Company

Contractor

COMPLETED

SECTION PLAT

250 Ft. from N. Line

----- Ft. from S. Line

----- Ft. from E. Line

250 Ft. from W. Line

	0		

ABANDONED

Location -----

Rig up -----

Drilling and Remarks:

Top line 1800'
1st Break 1807'
Dry & dho
S.D. 2482'

RECORD

Cased ----- in., ----- ft.

Sand -----

Gas -----

Oil -----

Total Depth 2482'

PRODUCTION

1st 24 hrs. Nat. -----

1st 24 hrs. after shot -----

Gas ----- Cu. Ft.

Dry Hole

Abandoned

Date

SEP 1 1 1925

192

CHAS. L. SHERWOOD

Scout