


Map No. KANSAS Sec 7 Twp. 27 R. 12E
Well No. 5 Sibel std Farm _____ Company _____

Greenwood

NORTH

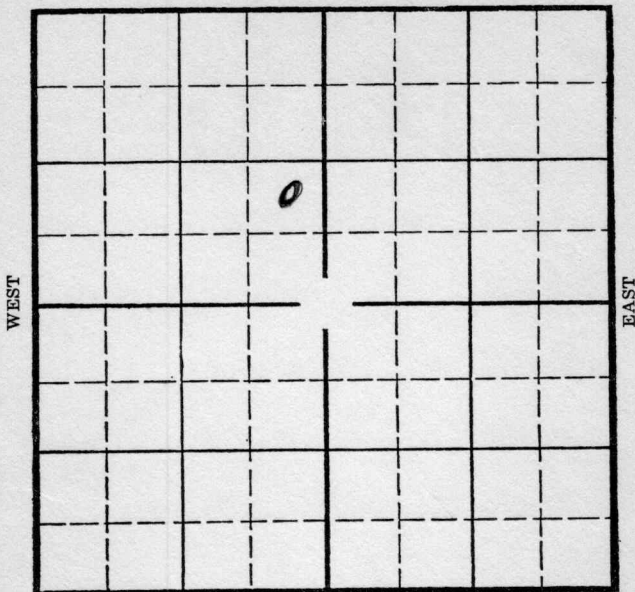

SOUTH

Location _____
Drilling Remarks _____

Rig Up _____
Drilling Remarks _____

RECORD

Cased _____ in. _____ ft.
Sand _____
Gas _____
Oil _____
Total Depth _____

PRODUCTION

1st 24 hrs. Nat. _____
1st 24 hrs. after shot _____
Gas _____ cu. ft. _____
Dry Hole _____
Abandoned _____

Greenwood

Map No. KANSAS Sec. 7 Twp. 27 R. 12E


Well No. 1- Taylor Farm
Reibel et al Company

 Ft. from N. Line

990 Ft. from S. Line

330 Ft. from E. Line

 Ft. from W. Line

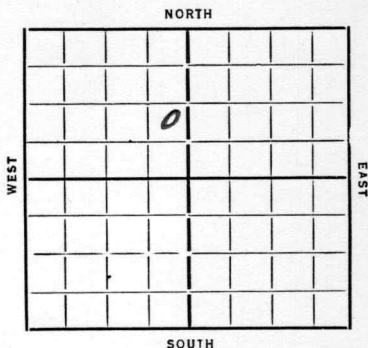

Date

REPORT

1935	
6/5	Location
6/13	Mch.
6/20	— 6/28 —
7/3	Spud
7/11	
7/18	slg 56
8/8	" 1120
8/15	—
8/22	1700 WR 6"
8/29	—
9/6	SD 1700
10/3	slg 1760
10/19	—
11/1	TD 1852 To drill in Thursday
	Expect pay next 3 feet
11/7	slg 1900
11/14	—
11/20	TD 1926
	D. & A.

ABANDONED

Map No. 9 Sec. 7 Twp. 27 R. 12 EWell No. 1-TaylorSeibel et al Company

Contractor

SECTION PLAT

	0		

Ft. from N. Line

990 Ft. from S. Line330 Ft. from E. Line

Ft. from W. Line

Location ✓

Rig up

Drilling and Remarks:

RECORD

Cased in., ft.Sand Gas Oil Total Depth

PRODUCTION

1st 24 hrs. Nat. 1st 24 hrs. after shot Gas Cu. Ft.Dry Hole Abandoned

Date

6-5-35 192 Scout

ORVAL MANNSCHRECK

Map No. 9 Sec. 7 Twp. 27 R. 12 E

Well No. 1-Taylor

Seibel et al Company

Contractor

ABANDONED

SECTION PLAT

	0		

Ft. from N. Line

990 Ft. from S. Line

330 Ft. from E. Line

Ft. from W. Line

Location

Rig up

Drilling and Remarks:

RECORD

Cased in., ft.

Sand

Gas

Oil

Total Depth 1926

PRODUCTION

1st 24 hrs. Nat.

1st 24 hrs. after shot

Gas Cu. Ft.

Dry Hole

Abandoned

Date

11-20-35 192

ORVAL MANNSCHRECK

Scout