

McPherson **KANSAS**

SECTION 24 TOWNSHIP 19 RANGE 1 W

WELL NO. #1-Leffler

COMPANY Muddy & Shepherd et al

NORTH

	0						

WEST

EAST

SOUTH

SEC. 24	TWP. 19	R. 1W
------------	------------	----------

WELL NO.

#1 Leffler

FARM

COMPANY

Mundy & Shepherd etal

CONTRACTOR

Carey

Coons


_____ Ft. from N. Line

_____ Ft. from S. Line

_____ Ft. from E. Line

_____ Ft. from W. Line

NE SW NW

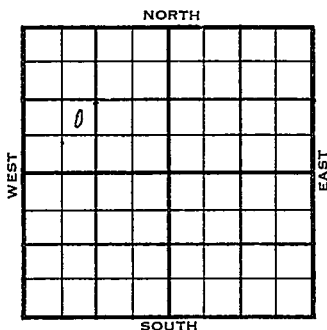

1956

ELEVATION
1586'

REPORT

1-18

MIR

2-8

Comm. 1-19-56

8 5/8" @ 138 w/110

DST 2920-40 op 1 hr. rec. 45' ocm & 60'

OCW & 180' SW, BHP 705

D & A

L. 2328

M. 2916

K. 3157

V. 3406

TD 3420'

ABANDONED

County McPherson Elev. _____
 Sec. 21 Twp. 19 Rge. 1W
 Company Mundy & Shepherd etal.
 Farm Name Leffler No. 1

TOPS	DEPTH	LOG	DATUM
Anh.			
TP.			
H.			
Tr.			
Dg.			
Bl.			
L.			
K.C.			
B.K.C.			
Ce.			
C.			
M.			
M.			
K.			
Mz.			
Mo.			
V.			
S.			
S.			
A.			
R.			
PE.			
G.			
T.D.			

Loc. in Sec. NE SW NW

Geol. _____
 Contr. Carey

Pool Coons

JAN 18 1958
 FIRST REPORT

Date Comm. MIR

Co.
Lse.
No.
Sec.
T.
R.

County **McPherson** Elev. **1586**
 Sec. **24** Twp. **19** Rge. **1W**
 Company **Mundy & Shepherd et al.**
 Farm Name **Leffler** No. **1**

	TOPS	DEPTH	LOG	DATUM	Loc. in Sec.
Ant					NE SW NW
Ip					
H					
Tr					
Dg					
Bl					
L	✓	2328		742	Geol.
KC					Contr
AKC					Carey
Cc.					Pool
G	✓	2916		1330	Coons
M					
K		3157		1521	
Mz					
Ma	✓	3406		1820	
V					
S					
A					
R					
PC					
P					
ED		3420			

ABANDONED

Date Comm. **FEB 8 1956**
M I R JAN 25 '56 1-19-56 8 1/8
138/110 @ 1750 FEB 1 '56
DST 2920-40 1hr. run 45' OCM
+60' OCW +180' SW BHP 705
@ 7275 FEB 8 56
NO S. A.