

KANSAS

Greenwood


FORM 51 5M 10-41 PETROL



Section ~~29~~ 28 Township 27 Range 12-E

Well No. 1 Shell

Company LeBlane et al

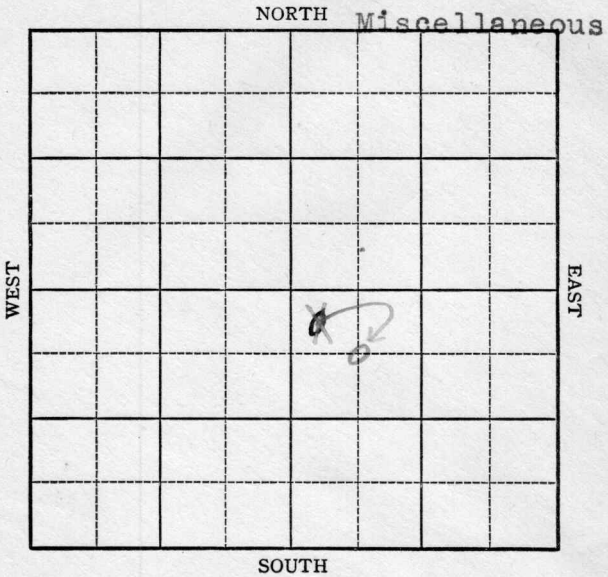

**KANSAS**

Greenwood

Sec. ~~29~~ 28 Twp. 27 R. 12-E

Well No. #1 Shell Farm \_\_\_\_\_

LeBlane et al. Company \_\_\_\_\_


(Miscellaneous)

330-660 Ft. from N. Line

\_\_\_\_\_ Ft. from S. Line

\_\_\_\_\_ Ft. from E. Line

330-660 Ft. from W. Line

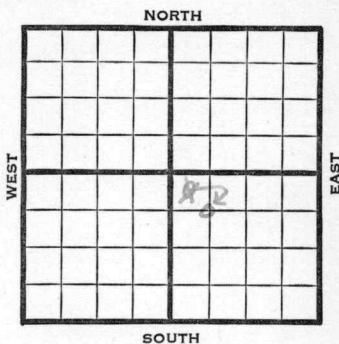

1941	REPORT
12/30	Machine
1942	
1/8	Shut down.
1/15	" "
1/22	" "
1/29	Spud 20'
2/5	12" - 40' Drlg. 145'
2/12	Drlg. 215'
2/19	Drlg. 700'
2/26	SD 750'
3/5	10" - 228' 8" - 800' T.D. 815' SD.
3/12	Lans. 575' K.C. 827' 8" - 867' 6" - 937' Drlg. 1006'
3/19	Drlg. 1150'
3/26	B.K.C. 1040' Oswego 1255' Drlg. 1275'
4/2	Drlg. 1560'
4/8	Miss. 1652' SD.
4/15	4" - 1645' C.O.
	<b>OVER</b>

1942				
4/22	TD 1649'	SD.		
4/29	"			
5/6	"			
5/13	"			
5/20	"			
5/27	2500 acid.	1000 Butane.		
	Pump 10 oil	a day.		
6/3	"	"	"	
6/10	"	"	"	
6/17	Miss. 1640'			
	4" - 1645'			
	T.D. 1652'			
	2500 acid.			
	1000 Butane			
	Potential 9 bbls.,	pump.		
	8. Gravity			

COMPLETED

Map No. 9 Sec. 29 Twp. 27 R. 12E

Well No. 1 Shell

LeBlane etal. Company

FIRST REPORT Contractor

NW SE

SECTION PLAT

330 Ft. from N. Line

\_\_\_\_\_ Ft. from S. Line

\_\_\_\_\_ Ft. from E. Line

330 Ft. from W. Line

		o	

MISCELLANEOUS

Location \_\_\_\_\_

Rig up \_\_\_\_\_

Drilling and Remarks:

Machine \_\_\_\_\_

RECORD

Cased \_\_\_\_\_ in., \_\_\_\_\_ ft.

Sand \_\_\_\_\_

Gas \_\_\_\_\_

Oil \_\_\_\_\_

Total Depth \_\_\_\_\_

PRODUCTION

1st 24 hrs. Nat. \_\_\_\_\_

1st 24 hrs. after shot \_\_\_\_\_

Gas \_\_\_\_\_ Cu. Ft.

Dry Hole \_\_\_\_\_

Abandoned \_\_\_\_\_

Date

DEC 30 1941

19

S. J. LEWIS Scout

Map No. 9 Sec. 28 Twp. 27 R. 12E

Well No. 1 Shell

LeBlane etal. Company

CORRECTION Contractor

C NW SE

SECTION PLAT

660 Ft. from N. Line

\_\_\_\_\_ Ft. from S. Line

\_\_\_\_\_ Ft. from E. Line

660 Ft. from W. Line

		0	

MISCELLANEOUS

Location \_\_\_\_\_

Rig up \_\_\_\_\_

Drilling and Remarks:

Reported

NW SE

29-27-12E

RECORD

Cased \_\_\_\_\_ in., \_\_\_\_\_ ft.

Sand \_\_\_\_\_

Gas \_\_\_\_\_

Oil \_\_\_\_\_

Total Depth \_\_\_\_\_

PRODUCTION

1st 24 hrs. Nat. \_\_\_\_\_

1st 24 hrs. after shot \_\_\_\_\_

Gas \_\_\_\_\_ Cu. Ft.

Dry Hole \_\_\_\_\_

Abandoned \_\_\_\_\_

Date

MAY 13 1942

19

S. J. LEWIS

Scout

Greenwood KANSAS

Map No. 9 Sec. 28 Twp. 27 R. 12E

Well No. 1 Shell

LeBlane et al. Company

**COMPLETEL** Contractor

C NW SE

SECTION PLAT

660 Ft. from N. Line

\_\_\_\_\_ Ft. from S. Line

\_\_\_\_\_ Ft. from E. Line

660 Ft. from W. Line

		o	

MISCELLANEOUS

Location \_\_\_\_\_

Rig up \_\_\_\_\_

Drilling and Remarks:

*Miss 1640  
4" @ 1645  
2500 acid  
1000 Butane.  
Pump. 9 Pa  
80 Gr*

RECORD

Cased \_\_\_\_\_ in., \_\_\_\_\_ ft.

Sand \_\_\_\_\_

Gas \_\_\_\_\_

Oil \_\_\_\_\_

Total Depth 1652

PRODUCTION

1st 24 hrs. Nat. \_\_\_\_\_

1st 24 hrs. after shot \_\_\_\_\_

Gas \_\_\_\_\_ Cu. Ft.

Dry Hole \_\_\_\_\_

Abandoned \_\_\_\_\_

Date

JUN 17 1942 19

S. J. LEWIS Scout