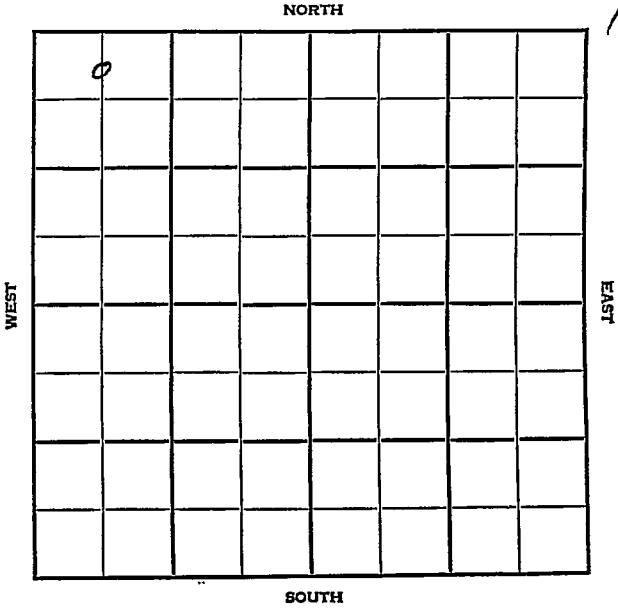


DX 78-1

Section 29 Township 19 Range 1W
Well No. #1 Wedel
Company Francis Hamm



McPherson

KANSAS

SEC.	TWP.	R.
29	19	1W

WELL NO.

#1 Wedel

FARM

COMPANY

Francis Hawn

CONTRACTOR

Musgrove

Ritz-Canyon Pool NORTH

330

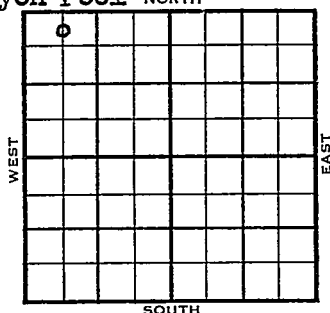
Ft. from N. Line

Ft. from S. Line

Ft. from E. Line

660

Ft. from W. Line

C N $\frac{1}{2}$ NW NW

ELEVATION

1951 1571'

REPORT

9/1 Spud 8-28-54

8" @ 150'

Dr1g. 2016'

10/6 Spud 8-28-54

Oil Well

TD 3000'

8" @ 150'

KC 2338', Cong 2933', Miss 2937'

DST 2968'-88' opn 1 hr, gas in 28 min
rec 45' ocm, 120' ho & gcm 60' Mud &
Wtr. 455#

TD 3000'

5" @ 3000'

CO to 2984'

18/ 2970-73

1 bo 1 bw A-frac. FU 1500' fluid

180' oil S/ 2.36 boph 90% Wtr.

Comp 7 bopd. 118 bw.

COMPLETED

County McPherson State KansasSec. 29 (Blk.) 19 (Sur.) 1W Map No.Operator Francis HawnWell No. 1 Farm WedelElev. Location C N $\frac{1}{2}$ NW NW

○						

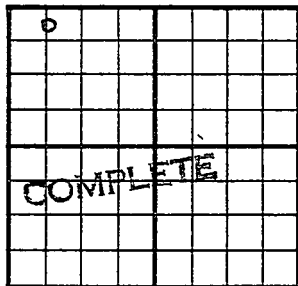
330 Ft. From N Line NW660 Ft. From W Line Quarter1st. Report SEP 1 1954

Completion

Remarks

Musgrove - Contr.Spudding Date 8-28-54Drlg. Data Ritz-Canton Pool8" @ 150 drlg. 2016

FABEN GILSTRAP

County McPherson State KansasSec. 29 (Blk. 19 (Sur. 1W (Twp. 1W Map No.Operator Francis HawnWell No. 1 Farm WedelElev. 1571 Location C N $\frac{1}{2}$ NW NW330 Ft. From N Line NW660 Ft. From W Line Quarter1st. ReportCompletion OCT 6 1954Remarks Ritz-Canton PoolMusgrove - Contr.Spudding Date 8-28-54Drlg. Data Oil well TD 30008" @ 150 KC 2338 Cong. 2933Miss. 2937 DST 2968-88 open 1 hr.gas in 28 min. Rec. 45' ocm 120' ho &gem 60' mud & wtr. 455# TD 30005" @ 3000 CO to 2984 18/ 2970-731 bo 1 bw A-frac FU 1500' fluid180' oil S/ 2.36 boph 90% wtr.Comp. 7 bopd 118 bw

FABEN GILSTR.