


Section 35 Township 23 Range 13E

Well No. #2 Betty "A"

Company Wondra

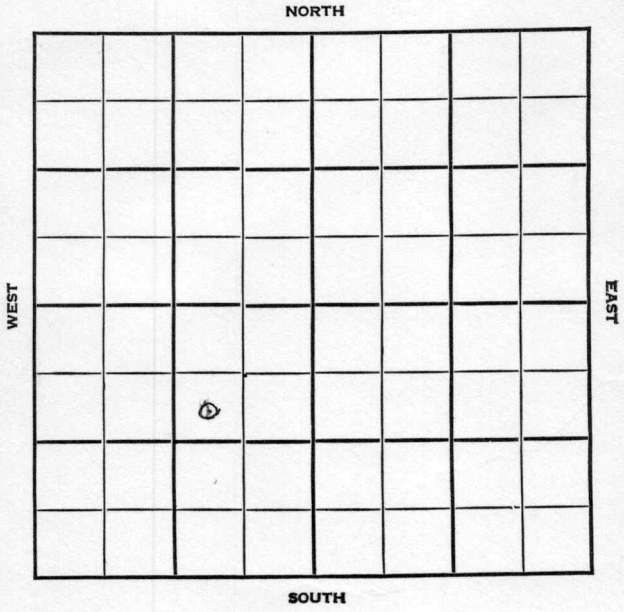

KANSAS

Woodson ✓

Sec. 35 Twp. 23 R. 13E

Well No. #2 Berry "A" Farm _____

Wondra Company
Virgil


990 Ft. from N. Line

_____ Ft. from S. Line

990 Ft. from E. Line

_____ Ft. from W. Line

SW NE SW

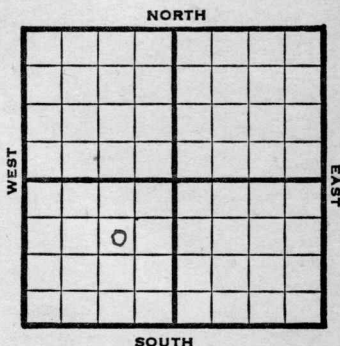

1948

REPORT

- 1/21 Machine.
- 1/26 "
- 2/4 Spud.
- 2/11 Drlg. 650'
- 2/18 "
- 2/25 10" @ 658'
- 8" @ 1258'
- Bart 1660' HFW
- Drlg. 1756'
- 3/3 "
- 3/10 Mississippi 1780'
- TD 1815'
- 5" @ 1805'
- 30 qts.
- 3/17 3000 acid Water.
- 3/24 Miss. 1780'
- TD 1815'

ABANDONED

Map No. _____ Sec. 35 Twp. 23 R. 13E

Well No. 2 Berry "A"

Wondra _____ Company

FIRST REPORT _____ Contractor

SW NE SW

SECTION PLAT

990 Ft. from N. Line

_____ Ft. from S. Line

990 Ft. from E. Line

_____ Ft. from W. Line

Woodson County

Location _____

Rig up _____

Drilling and Remarks:

Machine _____

RECORD

Cased _____ in., _____ ft.

Sand _____

Gas _____

Oil _____

Total Depth _____

PRODUCTION

1st 24 hrs. Nat. _____

1st 24 hrs. after shot _____

Gas _____ Cu. Ft.

Dry Hole _____

Abandoned _____

Date

JAN 21 1948 19

S. J. LEWIS Scout

