
FORM 51 5M 2-38 TPCO. McPherson KANSAS

Section 30 Township 19 Range 1-W

Well No. 1 Lewis

Company F. S. Williams et al

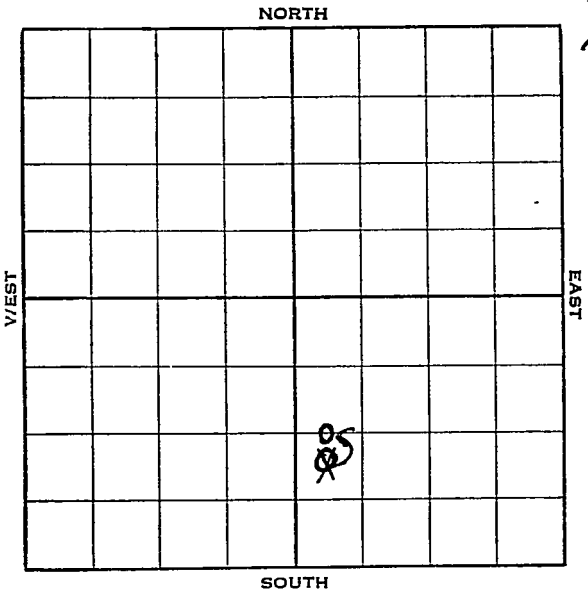

Form 252-A—5M—9-37 KANSAS - McPherson

Sec. 30 Twp. 19 R. 1-W

Well No. #1 Lewis Farm


F. S. Williams et al Company

1320 Ft. from N. Line

~~990~~ Ft. from S. Line

Ft. from E. Line

330 Ft. from W. Line

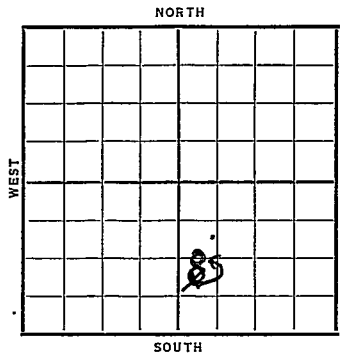

Date	REPORT
1938	
7/27	10" - 125'.
	Drlg. 2085'.
8/5	" "
8/12	5" - 2942'. T.D. 2962'.
	1600' oil. Testing.
8/17	5" at 2942'.
	Chat 2937'.
	T. D. 2962'.
	1000 acid.
	Potential 418 bbls.
	COMPLETED

Form 26—1M Bks.—2-29 McPherson KANSAS

Map No. 43 Sec. 30 Twp. 19 R. 1W

Well No. 1 Lewis

F. S. Williams etal Company

Contractor

FIRST REPORT

NW SW SE


Ft. from N. Line

990 Ft. from S. Line

Ft. from E. Line

330 Ft. from W. Line

SECTION PLAT

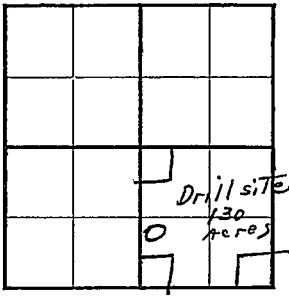

Location

Rig up

Drilling and Remarks:

10" - 125
Drg. 2085

RECORD

Cased in., ft.

Sand

Gas

Oil

Total Depth

PRODUCTION

1st 24 hrs. Nat.

1st 24 hrs. after shot

Gas Cu. Ft.

Dry Hole

Abandoned

Date

JUL 27 1938 19 H. D. Hatfield Scout

Form 26—1M Bks.—2-29 McPherson KANSAS

Map No. 43 Sec. 30 Twp. 19 R. 1 W

Well No. 1 - Lewis

Williams etal Company

Contractor

C W L SE CORRECTION

1 Ft. from N. Line


1320 Ft. from S. Line

Ft. from E. Line

330 Ft. from W. Line

CORRECTION

SECTION PLAT

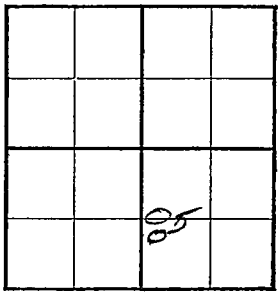

Location

Rig up

Drilling and Remarks:

first reported as nw sw se change to C W L SE

RECORD

Cased in., ft.

Sand

Gas

Oil

Total Depth

PRODUCTION

1st 24 hrs. Nat.

1st 24 hrs. after shot

Gas Cu. Ft.

Dry Hole

Abandoned

Date

AUG 3 - 1929 19 H. D. Hatfield Scout

Form 26—1M Bks.—2-29 McPherson KANSAS

Map No. 43 Sec. 30 Twp. 19 R. 1W

Well No. 1 Lewis

~~F. S. Williams etal~~ Company

Contractor

COMPLETED

C W L SE


_____ Ft. from N. Line

1320 Ft. from S. Line

_____ Ft. from E. Line

330 Ft. from W. Line

SECTION PLAT

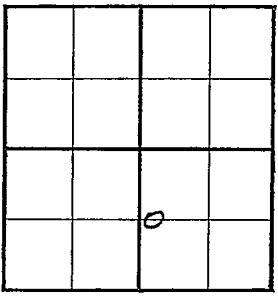

Location _____

Rig up _____

Drilling and Remarks:

1000 acid

POT 418

RECORD

Cased 5 in., 2942 ft.

~~Sand~~ Chat 2937

Gas _____

Oil _____

Total Depth 2962

PRODUCTION

1st 24 hrs. Nat. _____

1st 24 hrs. after shot _____

Gas _____ Cu. Ft.

Dry Hole _____

Abandoned _____

Date

AUG 17 1938 19____ H. D. Hatfield Scout