

Misc.

NORTH

WEST

EAST

SOUTH

KANSAS

Woodson



Sec. 35 Twp. 23 R. 13E

Well No. #2 Wells Farm

A. Wondra Company

Miscellaneous


         Ft. from N. Line

990 Ft. from S. Line

         Ft. from E. Line

330 Ft. from W. Line

NW SW NE

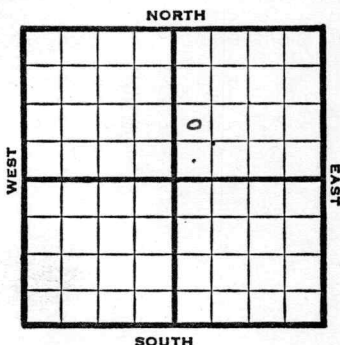

1947

# REPORT

7/23 Machine.

7/29 638' run 10"

8/6 10" @ 638'  
8" @ 1225'  
Dr1g 1360'

8/13 5" @ 1773½'  
6-5/8" @ 1500'  
Mississippi 1766  
SO 1803-05, 1½ B W  
1806-09 TD

8/20 SD

8/27 Miss. 1766'  
5" @ 1780'  
Pump 5 Pot  
Gr. 38°  
Total Depth 1817'

**COMPLETED**

KansasMap No. \_\_\_\_\_ Sec. 35 Twp. 23 R. 13EWell No. 2 Wells

\_\_\_\_\_ A. Wondra \_\_\_\_\_ Company

\_\_\_\_\_ FIRST REPORT \_\_\_\_\_ Contractor

NW SW NE

## SECTION PLAT

|  |  |   |  |
|--|--|---|--|
|  |  |   |  |
|  |  | 6 |  |
|  |  |   |  |
|  |  |   |  |
|  |  |   |  |

\_\_\_\_\_ Ft. from N. Line

990 Ft. from S. Line

\_\_\_\_\_ Ft. from E. Line

330 Ft. from W. Line

Woodson County

Location \_\_\_\_\_

Rig up \_\_\_\_\_

Drilling and Remarks:

Machine

## RECORD

Cased \_\_\_\_\_ in., \_\_\_\_\_ ft.

Sand \_\_\_\_\_

Gas \_\_\_\_\_

Oil \_\_\_\_\_

Total Depth \_\_\_\_\_

## PRODUCTION

1st 24 hrs. Nat. \_\_\_\_\_

1st 24 hrs. after shot \_\_\_\_\_

Gas \_\_\_\_\_ Cu. Ft.

Dry Hole \_\_\_\_\_

Abandoned \_\_\_\_\_

Date

JUL 23 1947

19

S. J. LEWIS

Scout

Map No. 17 Sec. 35 Twp. 23 R. 13E

Well No. 2 Wells

A. Wondra Company

COMPLETE Contractor

NW SWNE

SECTION PLAT

       Ft. from N. Line

990 Ft. from S. Line

       Ft. from E. Line

330 Ft. from W. Line

|  |  |   |  |
|--|--|---|--|
|  |  |   |  |
|  |  | 6 |  |
|  |  |   |  |
|  |  |   |  |
|  |  |   |  |

Woodsen County

Location                                 

Rig up                                 

Drilling and Remarks:

*Miss 1766*

*5' @ 1750*

*Pump 5' B & D*

*98-6*

RECORD

Cased        in.,        ft.

Sand                                 

Gas                                 

Oil                                 

Total Depth 1817

PRODUCTION

1st 24 hrs. Nat.                                 

1st 24 hrs. after shot                                 

Gas                                  Cu. Ft.

Dry Hole                                 

Abandoned                                 

Date

AUG 27 1947 19

S. J. LEWIS Scout