

KANSAS

Rice


Form 51-5M-7-39-Palace

Section 6 Township 18 Range 10-W

Well No. #4 Ames

Company Gulf

NORTH Bloomer Pool

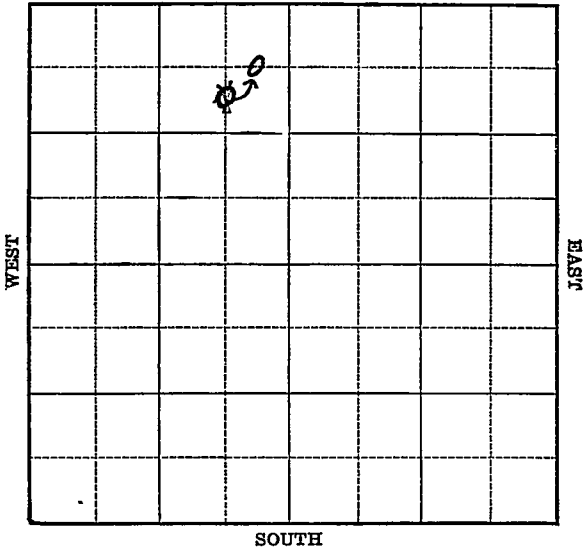

Rice

KANSAS

Map No. 53 Sec. 6 Twp. 18 R. 10WWell No. 4 Ames

Gulf

Company

Contractor

FIRST REPORT

SECTION PLAT

C $S\frac{1}{2}$ NE NW990 Ft. from N. Line

_____ Ft. from S. Line

660 Ft. from E. Line

_____ Ft. from W. Line

	o		

BLOOMER POOL

Location _____

Rig up _____

Drilling and Remarks:

Running derrick
corners

RECORD

Cased _____ in., _____ ft.

Sand _____

Gas _____

Oil _____

Total Depth _____

PRODUCTION

1st 24 hrs. Nat. _____

1st 24 hrs. after shot _____

Gas _____ Cu. Ft.

Dry Hole _____

Abandoned _____

Date

MAR 6 1940

19

S. J. LEWIS

Scout

Map No. _____ Sec. **6** Twp. **18** R. **10W**

Well No. **4 AMOS**

Gulf

Company

CORRECTION

Contractor

C E L NE NW

SECTION PLAT

990 Ft. from N. Line

_____ Ft. from S. Line

330 Ft. from E. Line

_____ Ft. from W. Line

BLOOMER POOL

Location _____

RECORD

Rig up _____

Cased _____ in., _____ ft.

Drilling and Remarks:

Sand _____

Gas _____

Reported

Oil _____

C S L NE NW

Total Depth _____

PRODUCTION

1st 24 hrs. Nat. _____

1st 24 hrs. after shot _____

Gas _____ Cu. Ft.

Dry Hole _____

Abandoned _____

Date

MAR 20 1940

S. J. LEWIS

Scout

Your drilling report shows this well corrected to C EL NE NW and spot & feet measurements shows well in SE NE NW.

Please check and advise.

- Paul.

Misc Small Maps.....	<i>Paul</i>
Cards.....	<i>Paul</i>
Tracing.....	<i>Paul</i>
France Map.....	<i>Paul</i>
Scarborough Map.....	<i>Paul</i>
Moody Map.....	
Geological Dept.	
Moody Flat Book	

Map No. 55 Sec. 6 Twp. 18 R. 10W

Well No. 4 Ames

Gulf Company

CORRECTION Contractor

C E L N E N W

660 Ft. from N. Line

_____ Ft. from S. Line

330 Ft. from E. Line

_____ Ft. from W. Line

BLOOMER POOL

SECTION PLAT

		o	

Location _____

Rig up _____

Drilling and Remarks:

Gave wrong
foot measurements

RECORD

Cased _____ in., _____ ft.

Sand _____

Gas _____

Oil _____

Total Depth _____

PRODUCTION

1st 24 hrs. Nat. _____

1st 24 hrs. after shot _____

Gas _____ Cu. Ft.

Dry Hole _____

Abandoned _____

Date

MAR 25 1940

S. J. LEWIS

Scout

Rice

Map No. 55 Sec. 6 Twp. 18 R. 10W

Well No. 4 Ames

Gulf Company

Contractor

COMPLETED

SECTION PLAT

C E L NE NW

660 Ft. from N. Line

_____ Ft. from S. Line

330 Ft. from E. Line

_____ Ft. from W. Line

BLOOMER POOL

		0	

Location _____

Rig up _____

Drilling and Remarks:

Oil & 3224
5" @ 3225.
20.00 each
Depthograph P & X
6135

Maximum 3000

RECORD

Cased _____ in., _____ ft.

Sand _____

Gas _____

Oil _____

Total Depth 3230

PRODUCTION

1st 24 hrs. Nat. _____

1st 24 hrs. after shot _____

Gas _____ Cu. Ft.

Dry Hole _____

Abandoned _____

Date

APR 3 1940

S. J. LEWIS Scout