

Woodson

Map No. **KANSAS** Sec. 36 Twp. 23 25 R. 13E


Well No. 1 Sage Farm
 Nye & Kilby Company

.....Ft. from N. Line

275 Ft. from S. Line

275 Ft. from E. Line

.....Ft. from W. Line

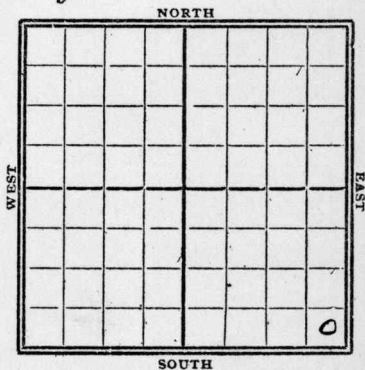

| Date | REPORT |
|--------|--|
| 7/9/34 | |
| 4/4 | Machine |
| 4/18 | Dlg 755 |
| 4/26 | Fog 862 |
| 5/3 | Dlg 1040 |
| 5/10 | Lime 1727 Pay 1752-59 1 Bbl per hr Will acidize |
| 5/18 | — |
| 5/30 | Pay 1752-59 TD 2600 Gal acid 55 Bbls oil |
| | 70 " water |
| | COMPLETED |

Map No. 17 Sec. 36 Twp. 25 R. 13E

Well No. 1 Sage

W. H. & K. H. Kelly Company

Contractor

FIRST REPORT

SECTION PLAT

_____ Ft. from N. Line

225 Ft. from S. Line

275 Ft. from E. Line

_____ Ft. from W. Line

| | | | |
|--|--|--|---|
| | | | |
| | | | |
| | | | |
| | | | 0 |

Location _____

Rig up _____

Drilling and Remarks:

Machin

RECORD

Cased _____ in., _____ ft.

Sand _____

Gas _____

Oil _____

Total Depth _____

PRODUCTION

1st 24 hrs. Nat. _____

1st 24 hrs. after shot _____

Gas _____ Cu. Ft.

Dry Hole _____

Abandoned _____

Date

1-4-34 1934 O. M. Manschuet Scout

KANSAS

KANSAS

Map No. Sec. 36 Twp. 23 R. 13E

Well No. 1 - Sage

Nye & Kilby Company

Contractor

CORRECTION

SECTION PLAT

..... Ft. from N. Line

225 Ft. from S. Line

275 Ft. from E. Line

..... Ft. from W. Line

| | | | |
|--|--|--|---|
| | | | |
| | | | |
| | | | |
| | | | |
| | | | 0 |

CORRECTION

Location

Rig up

Drilling and Remarks:

formerly reported 36-25-1320

RECORD

Cased.....in.,ft.

Sand.....

Gas.....

Oil.....

Total Depth.....

PRODUCTION

1st 24 hrs. Nat.....

1st 24 hrs. after shot.....

Gas.....Cu. Ft.

Dry Hole.....

Abandoned.....

Date

4-11-34 192

Scout

Map No. KANSAS Sec. 06 Twp. 23 R. 13E

Well No. 1 Sage

Nye & Kilby Company
Contractor

SECTION PLAT

| | | | |
|----------|--|--|--|
| | | | |
| COMPLETE | | | |
| | | | |
| | | | |

_____ Ft. from N. Line
225 Ft. from S. Line
275 Ft. from E. Line
_____ Ft. from W. Line

RECORD

Location _____

Cased _____ in., _____ ft.

Rig up _____

Sand _____

Drilling and Remarks:

Gas _____

Pay 1752 - 59 PD

Oil _____

Total Depth _____

2000 gal acid

PRODUCTION

1st 24 hrs. Nat. _____

5588 gal oil

1st 24 hrs. after shot _____

70 " water

Gas _____ Cu. Ft.

Dry Hole _____

Abandoned _____

Date

5/30

1934

ORVAL MANNSCHRECK Scout