
WOODSON

Form 51—5M—3-35—Mid-West

Map No. KANSAS Sec. 36 Twp. 23 R. 13-E

Well No. 1-Sage Farm

Braden et al Company

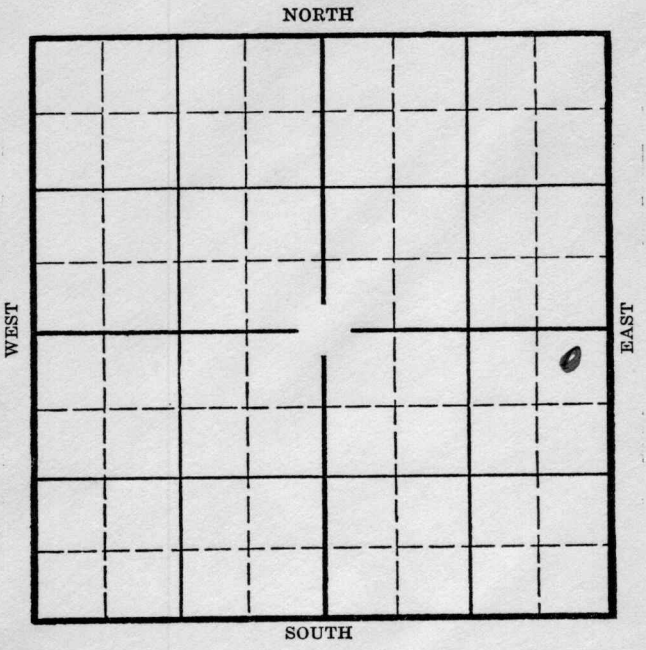

Location

Drilling Remarks

Rig Up

Drilling Remarks

RECORD

Cased in. ft.

Sand

Gas

Oil

Total Depth

PRODUCTION

1st 24 hrs. Nat.

1st 24 hrs. after shot

Gas cu. ft.

Dry Hole

Abandoned

Form 252-A
5M 7-35 MPC

Woodson

KANSAS

Map No. _____ Sec. 36 Twp. 23 R. 13E

Well No. 1 Sage Farm


Braden etal Company

330 Ft. from N. Line

_____ Ft. from S. Line

330 Ft. from E. Line

_____ Ft. from W. Line

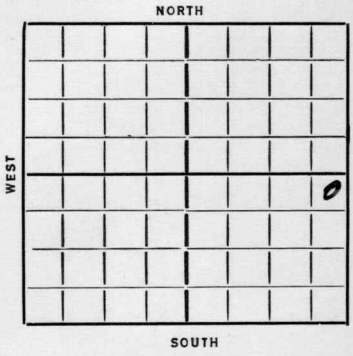

Date	REPORT
1936	
3/4	Dlg 1335
3/18	Miss 1709
	TD 1759
	D & A.

ABANDONED

Form 26—1M Blks. 9-28

KANSAS

Wilson

Map No. 17 Sec. 36 Twp. 23 R. 13E

Well No. 1- Sage

Braden etal Company

Contractor

FIRST REPORTS


330 Ft. from N. Line

Ft. from S. Line

330 Ft. from E. Line

Ft. from W. Line

SECTION PLAT

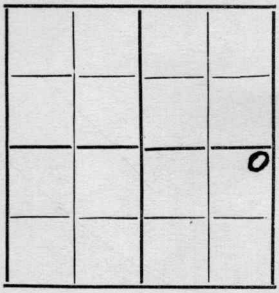

Location

Rig up

Drilling and Remarks:

Dlg 1335

RECORD

Cased in., ft.

Sand

Gas

Oil

Total Depth

PRODUCTION

1st 24 hrs. Nat.

1st 24 hrs. after shot

Gas Cu. Ft.

Dry Hole

Abandoned

Date

3-11-36 192

ORVAL MANNSCHRECK Scout

Woodson

Form 26—1M Bks. 9-28

KANSAS

Map No. 17 Sec. 36 Twp. 23 R. 16E

Well No. 1 - Sage

Braden etal Company

Contractor

COMPLETED


330 Ft. from N. Line

Ft. from S. Line

330 Ft. from E. Line

Ft. from W. Line

SECTION PLAT

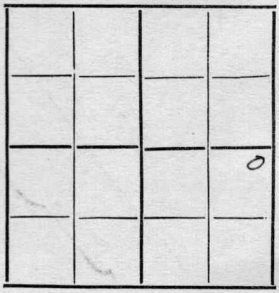

Location

Rig up

Drilling and Remarks:

D & A

RECORD

Cased in., ft.

~~Sand~~ Miss. 1709

Gas

Oil

Total Depth 1759

PRODUCTION

1st 24 hrs. Nat.

1st 24 hrs. after shot

Gas Cu. Ft.

Dry Hole

Abandoned

Date

MAR 18 1936 192

ORVAL MANNSCHRECK Scout