


Section 1 Township 19 Range 12-W

Well No. #1 Habiger

Company Aladdin & Crowe

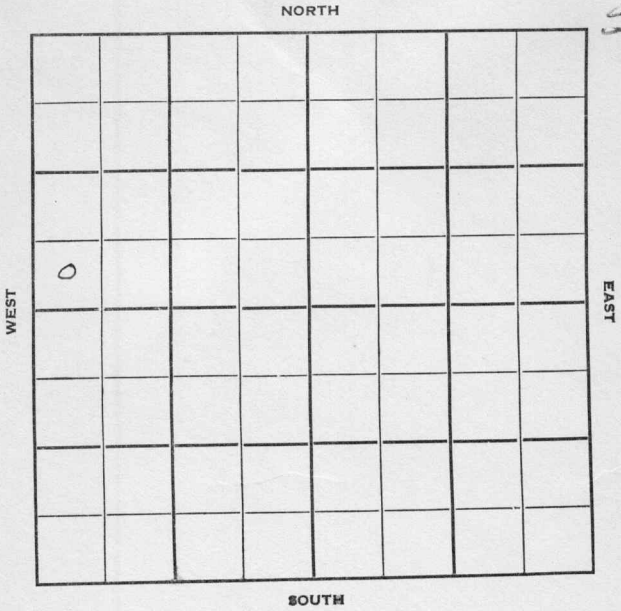

Sec. 1 Twp. 19 R. 12-W

Well No. #1 Habiger Farm

Aladdin & Crowe Company

Crowe Drlg. - Contr. Contractor

Wildcat


         Ft. from N. Line

330 Ft. from S. Line

         Ft. from E. Line

330 Ft. from W. Line

SW SW NW  
Sohio farmout

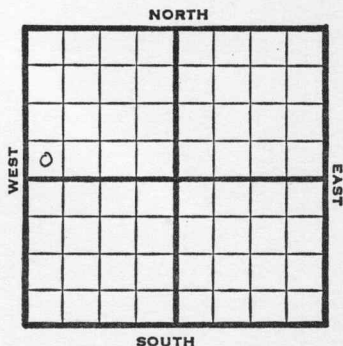

1950 Elev 1830 REPORT

9/6 RUR

11/29 Spud 9-5-50  
Oil Well TD 3430  
8" @ 244 Anhy 644-85'  
Lans. 3128'  
DST 2937-65 opn 1 hr. Rec. 35' mud  
DST 3130-3202 opn 1 hr Rec. 30' so &  
gcm  
DST 3256-3310 opn 1 hr Rec. 90' socm  
Cong. 3387' DST 3389-3405 opn 1 hr  
Rec. 450' oil 5" @ 3388  
TD 3405' S/48 bo 18 hr.  
P/9½ bopd DD Arb. 3414  
TD 3430 25 go 20 gw PB 3365  
34/3337-46 22/3328-34 PB 3322  
24/3315-21 22/3283-89  
24/3270-76 ½ go 48/3250-62  
2000 A FU 750' fluid 50% oil  
S/2 bo 10 bwph PB 3205  
18/3186-92 24/3170-78  
30/3116-26 2000 A 3 bo 11 hr.  
P 28 bo 4 bwph  
Comp. 118 bopd 35% wtr.

COMPLETED



County Barton State Kansas

Sec. 1 (Blk.) 19 (Sur.) 12W Map No. (Twp.) (Rge.)

Operator Aladdin & Crowe Drlg.

Well No. 1 Farm Habiger

Elev. 1830 Location SW SW NW


330 Ft. From S Line NW

330 Ft. From W Line Quarter

Ist. Report

Completion NOV 29 1950

Remarks Cheyenne View Pool  
Crowe Drlg. - Contr.

Spudding Date 9-5-50

Drlg. Data Oil well TD 3430

8" @ 244 Anhy 644-85 Lans. 3128

DST 2937-65 open 1 hr. Rec. 35' mud

DST 3130-3202 open 1 hr. Rec. 30' so & gcm

DST 3256-3310 open 1 hr. Rec. 90' socm

Cong. 3387 DST 3389-3405 open 1 hr.

Rec. 450' oil 5" @ 3388 TD 3405

S/ 48 bo 18 hr. P/ 9 1/2 bopd

DD Arb. 3414 TD 3430 25 go 20 gw

PB 3365 34/ 3337-46 22/ 3328-34

PB 3322 24/ 3315-21 22/ 3283-89

24/ 3270-76 1/2 go 48/ 3250-62 2000 A

FU 750' fluid 50% oil S/ 2 bo 10 bwph

PB 3205 18/ 3186-92 24/ 3170-78

30/ 3116-26 2000 A 3 bo 11 hr.

Drig. Data

P/ 28 bo 4 bwpd

Comp. 118 bopd 35% water

DEC 5 1950

Scout Cards	.....
Land Small Map	.....
Land Wall Map	.....
Tracings	.....
France Map	.....
Pierce Map	.....
Misc.	.....

*[Handwritten scribbles and a large curved line are present over the form.]*